


T.7S. R.4W. W.M.

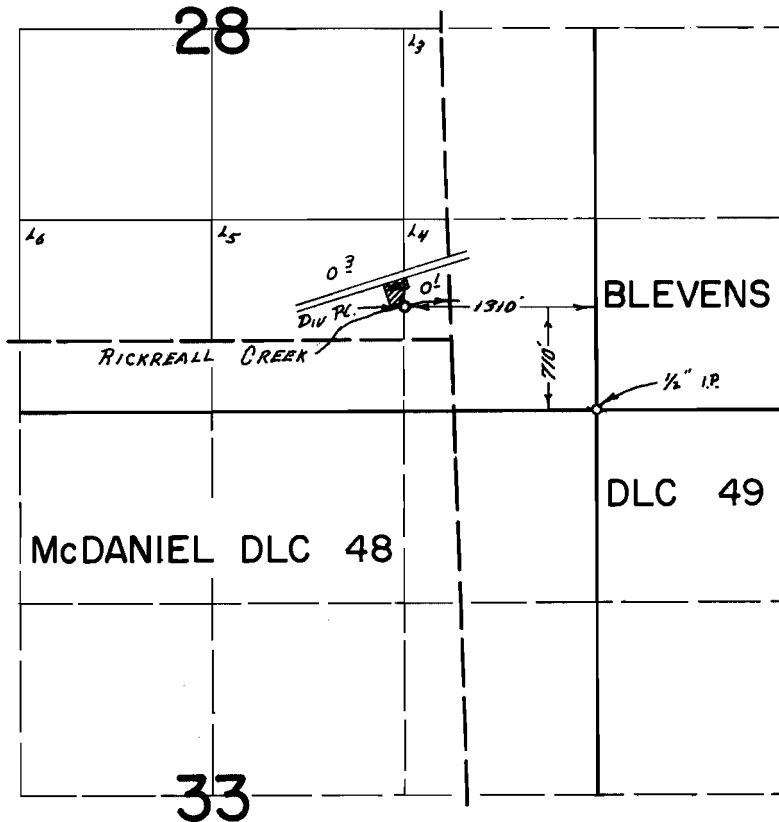

FINAL PROOF SURVEY UNDER

Application No. 48362 Permit No. 36309
IN NAME OF

EMERY DENTEL

Surveyed APRIL 5 1973, by R. G. Mucken