


T.9S. R.5W. W.M.

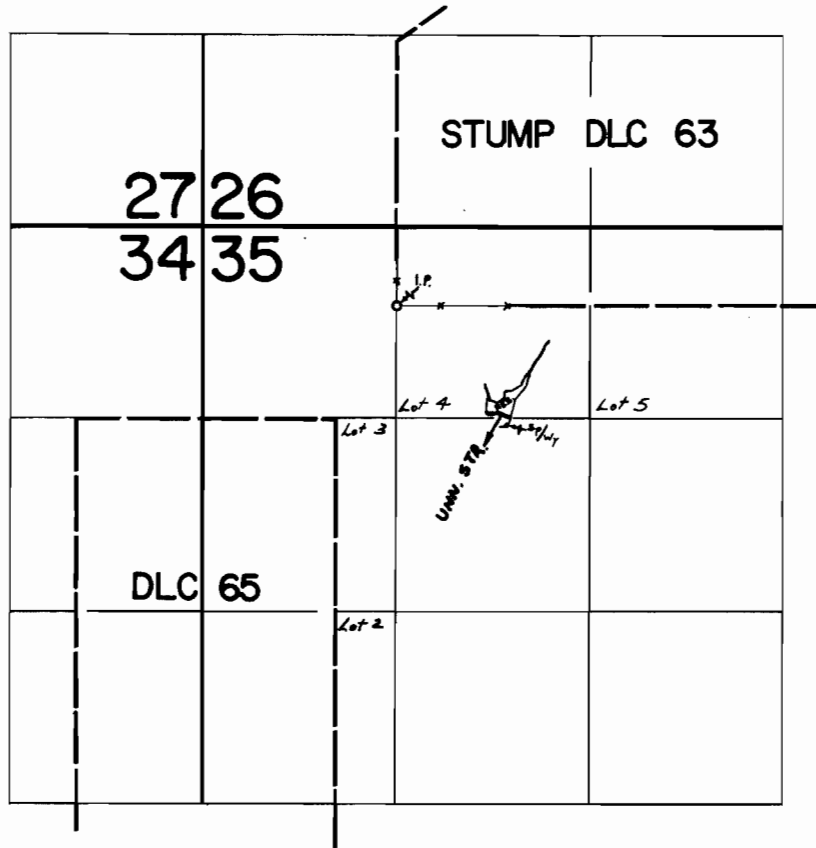

FINAL PROOF SURVEY
UNDER

Application No. R-44142 Permit No. R-5093

IN NAME OF

R. ROLAND CROSIAR

Surveyed MARCH 14, 1973, by R. MUCKEN