





# T.9S. R.4W. W.M.

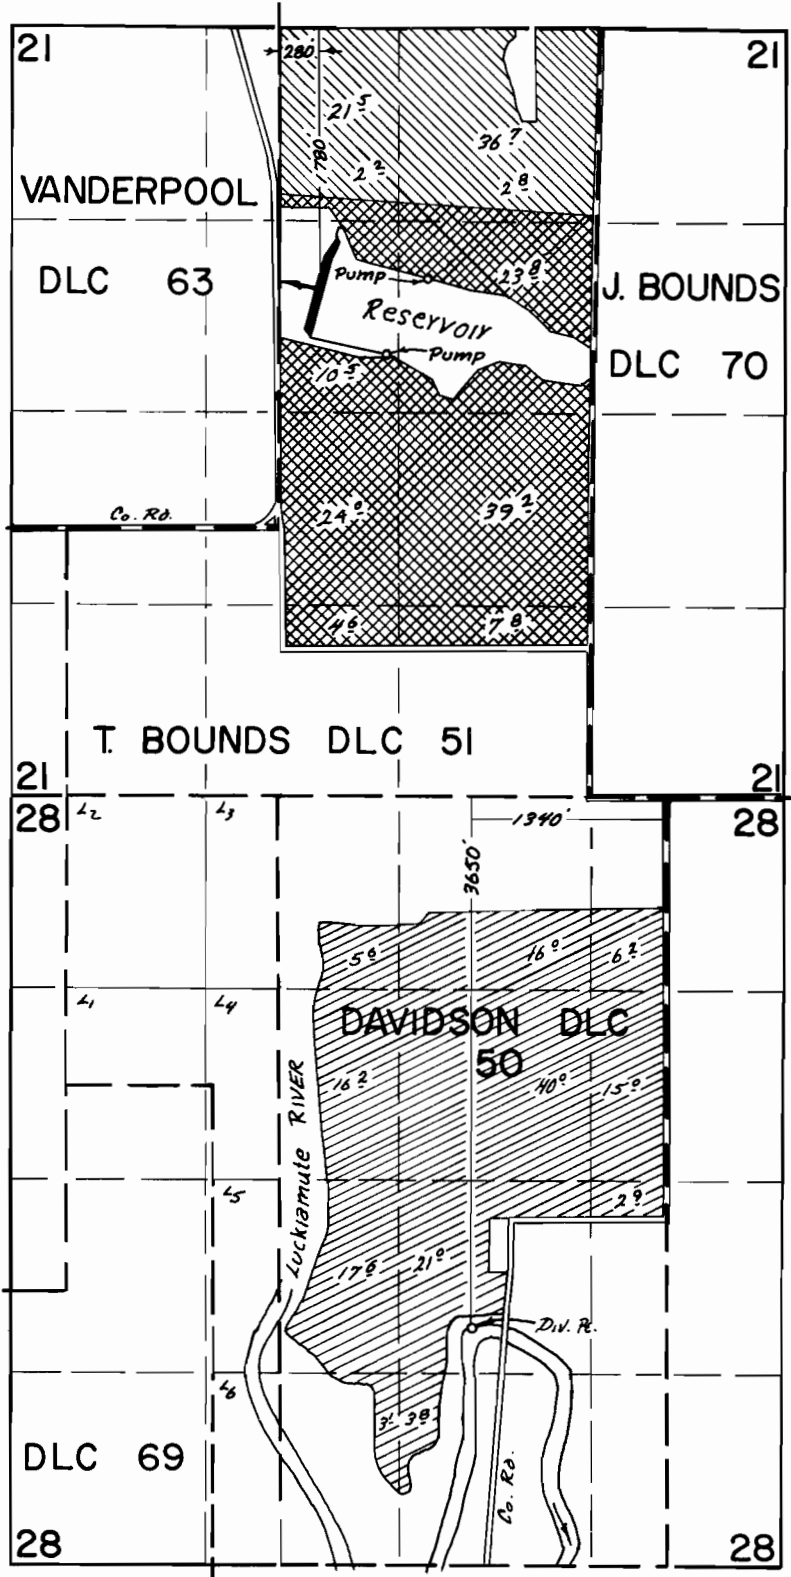

-  Primary P. # 31202
-  Primary P. # 33213
-  Primary P. # 32224  
Supplemental P. # 33213

## FINAL PROOF SURVEY

UNDER  
 41713 31202  
 43131 32224  
 Application Nos. R-45242 Permit Nos. R-5155  
 45243 33213

IN NAME OF

*DESERT SEED COMPANY INC.*

Surveyed March 21, 1973, by R. G. MUCKEN