


T.8S. R.5&6W. W.M.

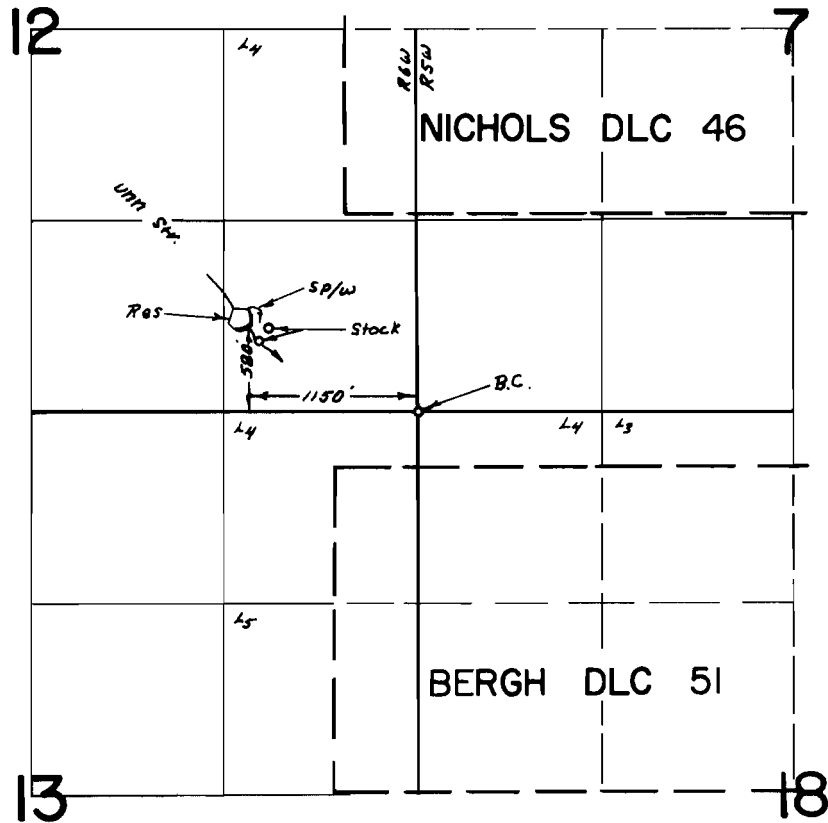

FINAL PROOF SURVEY
UNDER

Application No. R- 46483 46484 Permit No. R- 5542 34739

IN NAME OF

HARRY F. ELIANDER, JR.

Surveyed April 3 1973, by R.G. Mucken