


T.8S. R.5&6W. W.M.

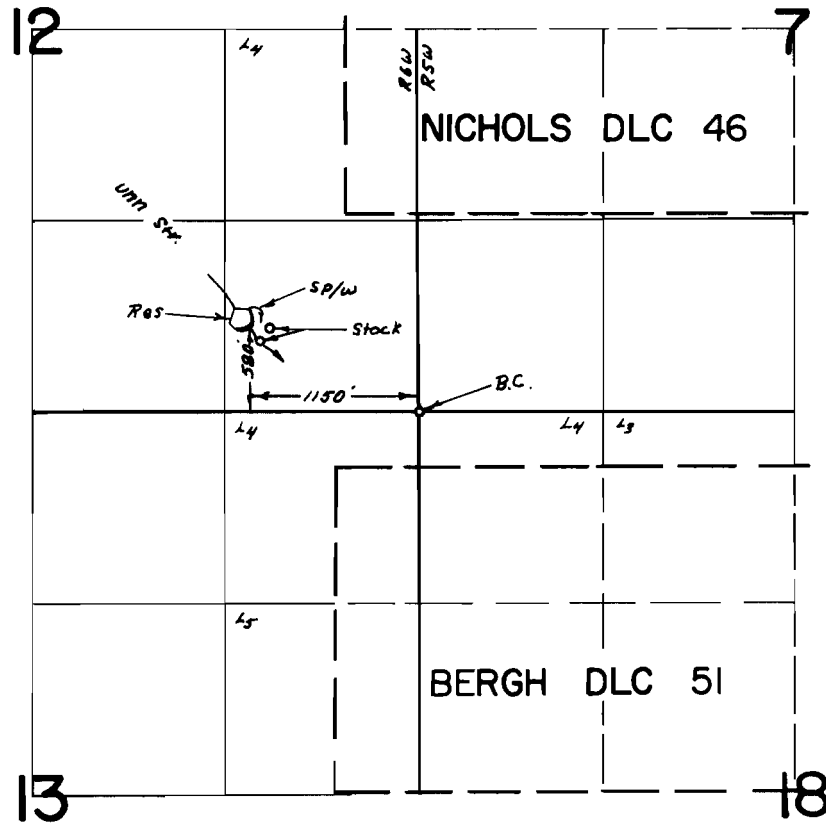

FINAL PROOF SURVEY UNDER

Application No. R-46483 46484 Permit No. R-5542 34739

IN NAME OF

HARRY F. ELIANDER, JR.

Surveyed April 3 1973, by R.G. Mucken