


T.9S. R.5W. W.M.

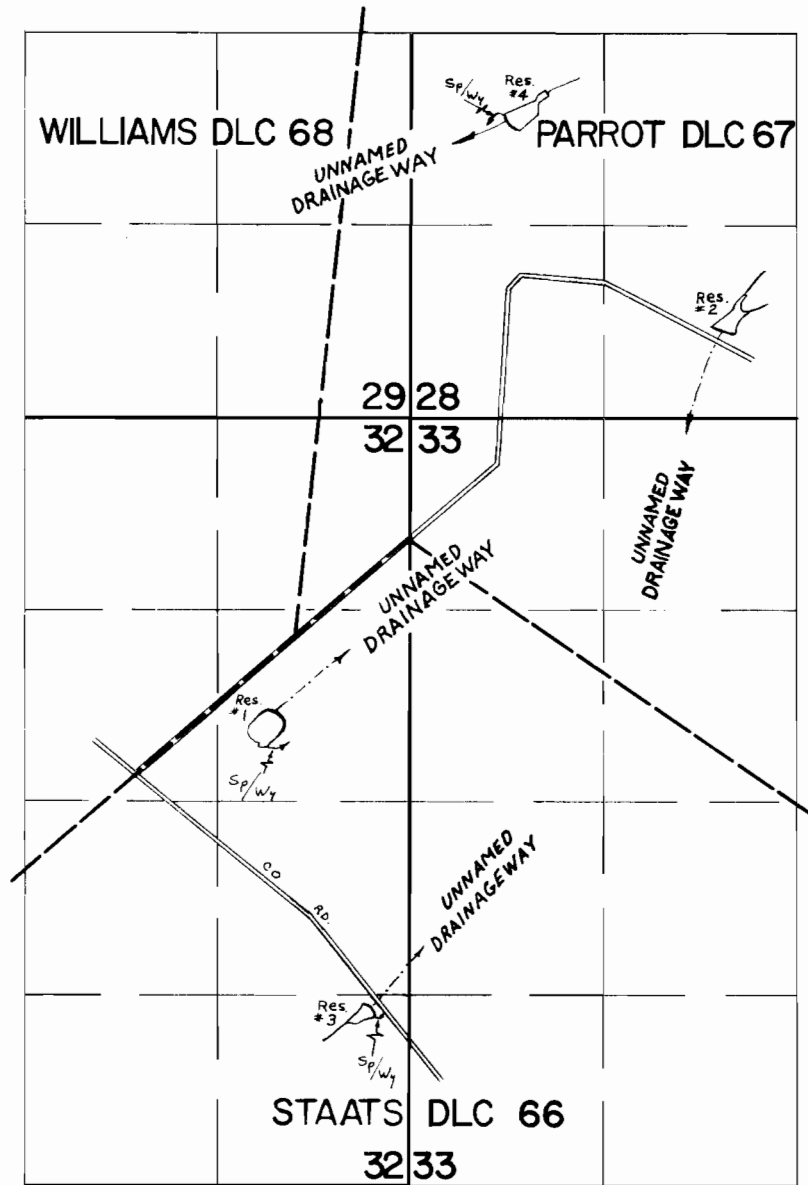

FINAL PROOF SURVEY
UNDER

Application No. R-46854 Permit No. R-5616
IN NAME OF

LOUIS HAMILTON

Surveyed MARCH 15, 1973, by R. MUCKEN