


T.9S. R.5W. W.M.

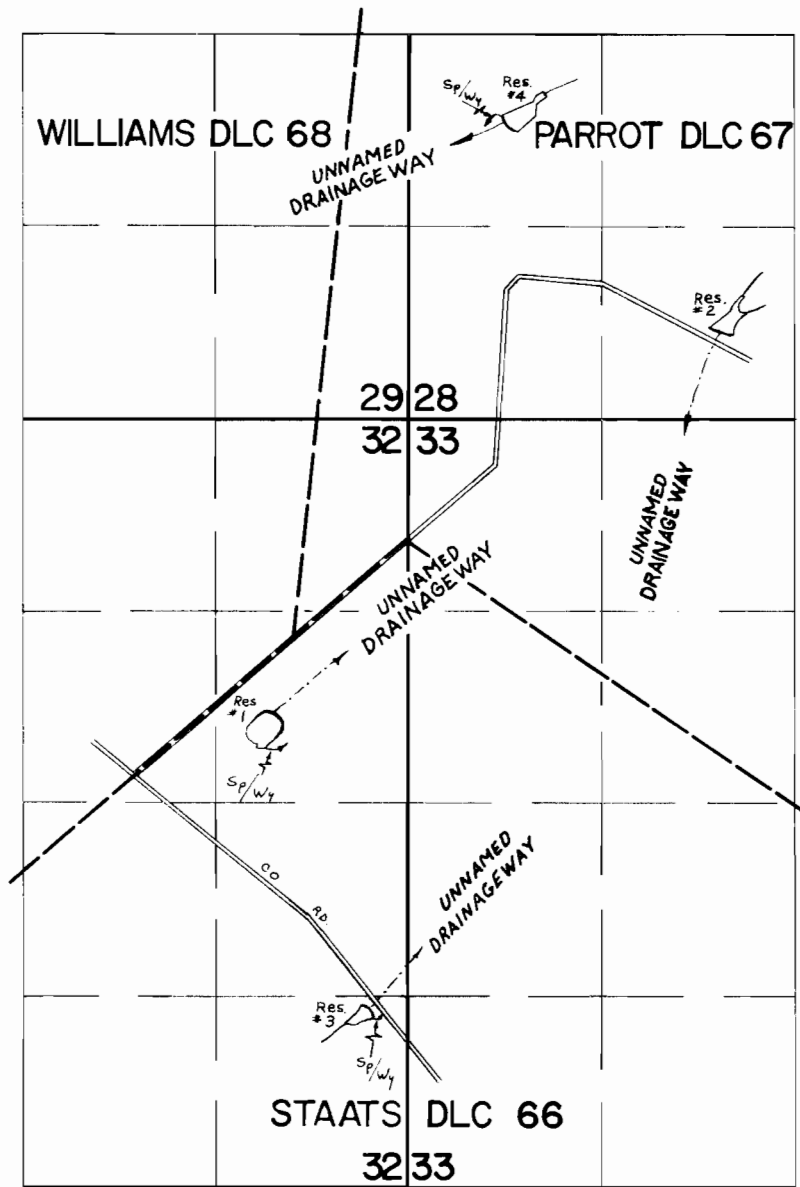

**FINAL PROOF SURVEY**  
UNDER

Application No. R-46854 Permit No. R-5616  
R-46855 R-5617  
IN NAME OF

LOUIS HAMILTON

Surveyed MARCH 15, 1973, by R. MUCKEN