


# T.7S. R.38&4W. W.M.

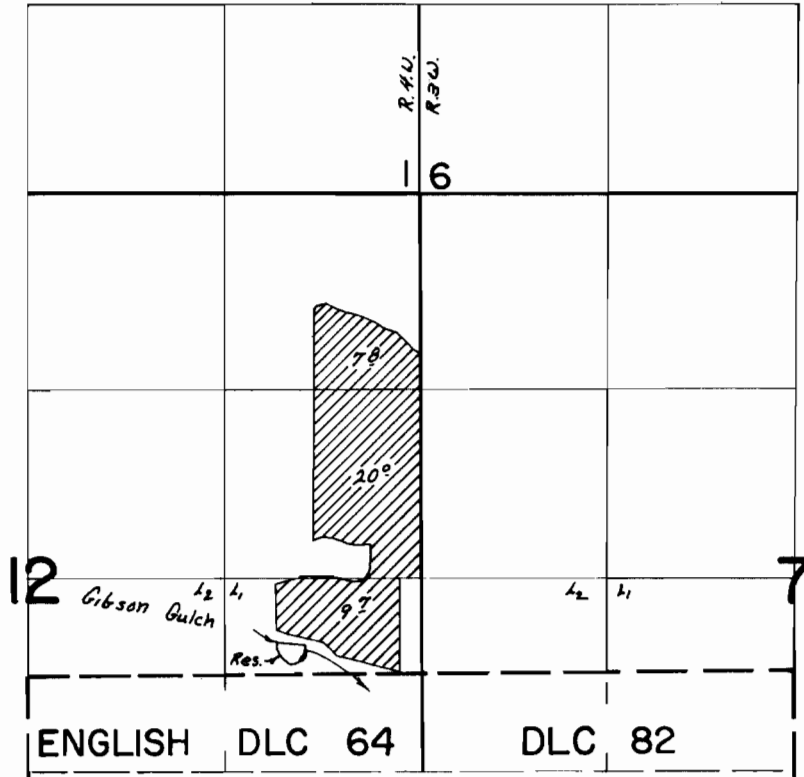

Dem Loc. 500'S + 800' W From E 1/4 Cor. Sec. 12

## FINAL PROOF SURVEY UNDER

Application No. <sup>R-47148</sup> 47149 Permit No. <sup>R-5695</sup> 35429

IN NAME OF

JESSE HAINES

Surveyed April 6, 1979, by R.B. Mucken