


T.7S. R.4W. W.M.

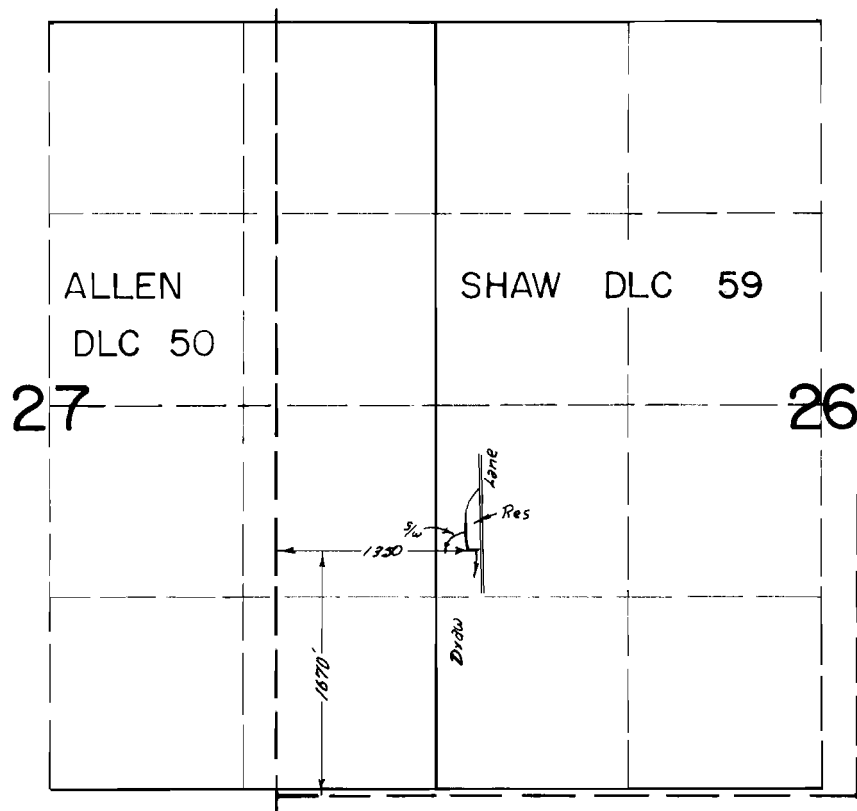

**FINAL PROOF SURVEY**  
UNDER

Application No. R-47436 Permit No. R-5717  
IN NAME OF

VIRGIL MYERS

Surveyed April 5 1973, by R.B. Mucken