


T.8S. R.5W. W.M.

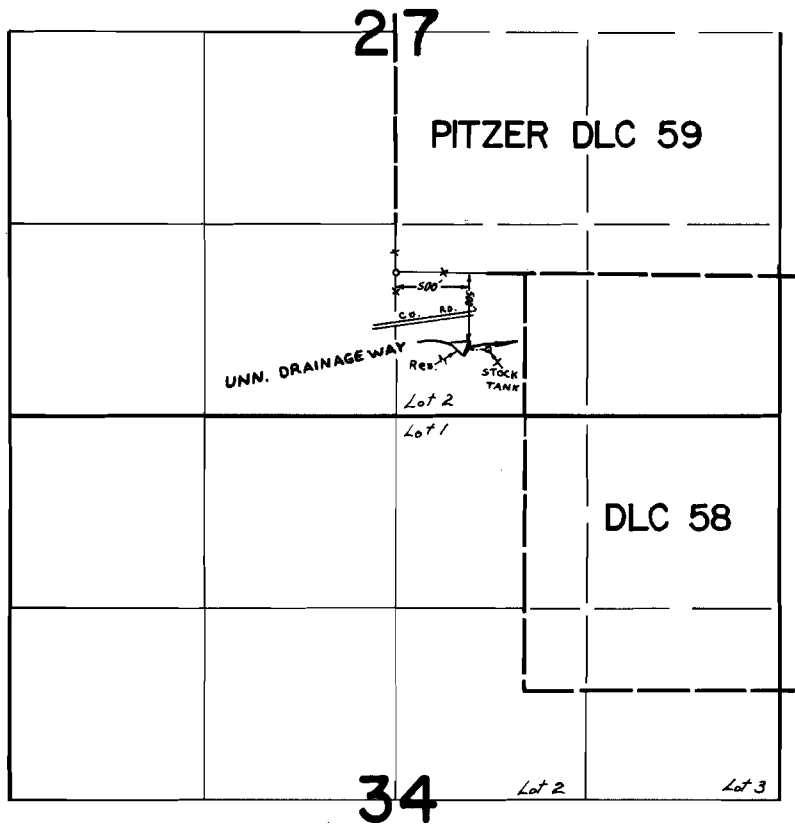

FINAL PROOF SURVEY
UNDER

Application No. R-48171 48172 Permit No. R-5862 36188
IN NAME OF

K. H. LENHARD

Surveyed MARCH 29, 1973, by R. MUCKEN