


T.8S.R.5W.W.M.

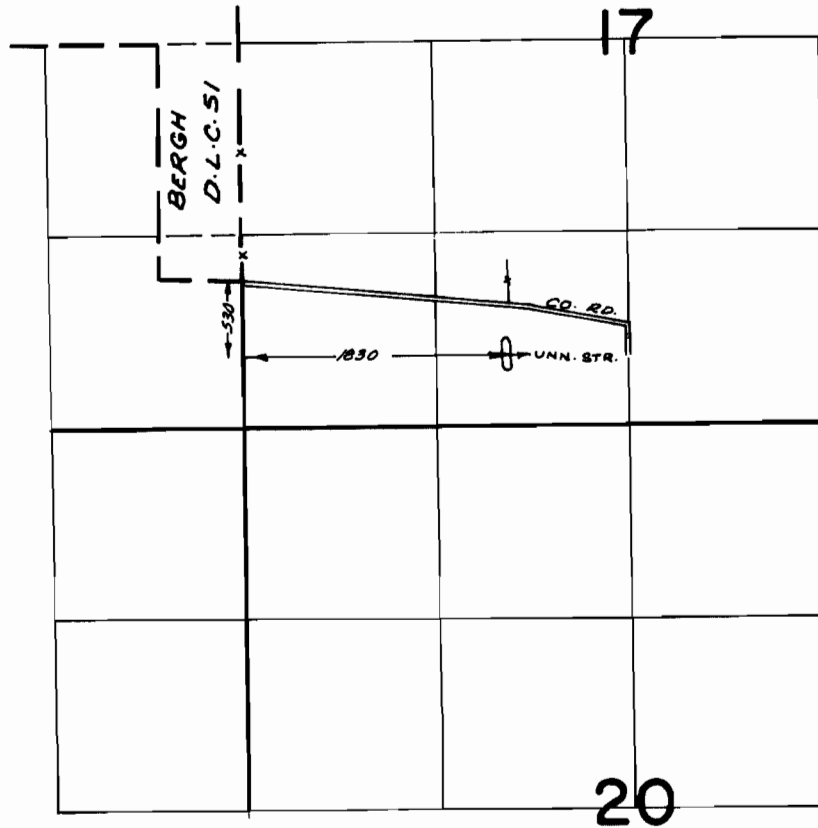

FINAL PROOF SURVEY
UNDER

Application No. R-47318 Permit No. R-5871
IN NAME OF

LAWRENCE KINSEY

Surveyed MAR 30 19 73, by R. MUCKEN