


G-3971  
41756

T.3N., R.28E., W.M.

CANCELLED  
V49 P239

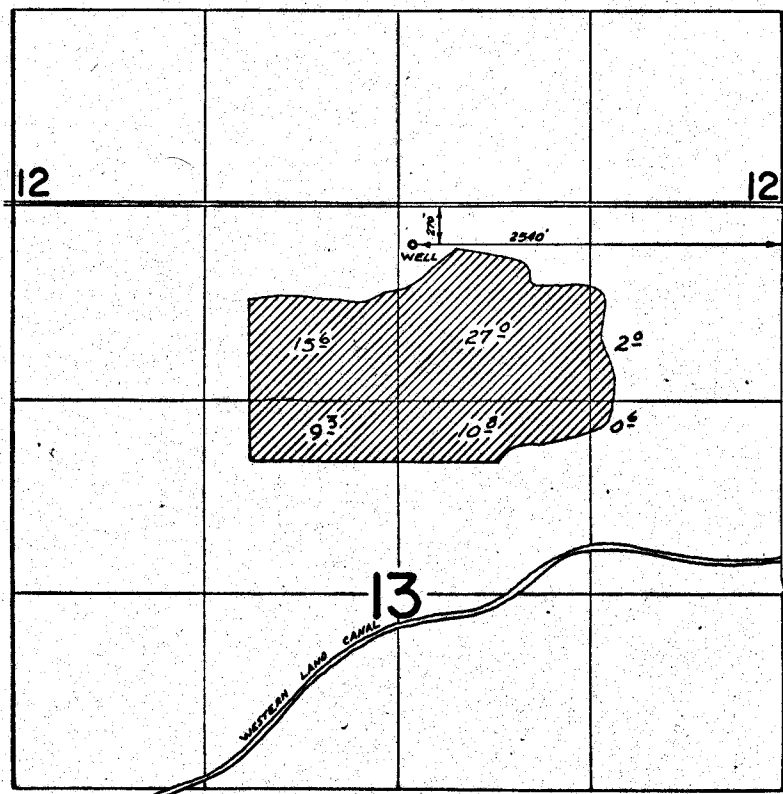

**FINAL PROOF SURVEY**  
UNDER

Application No. G-4207 Permit No. G-3971  
IN NAME OF

HOWARD S. and VERA G. STONE

Surveyed April 19, 1974, by D. Dorby