


T. 1S. R. 39E. W.M.

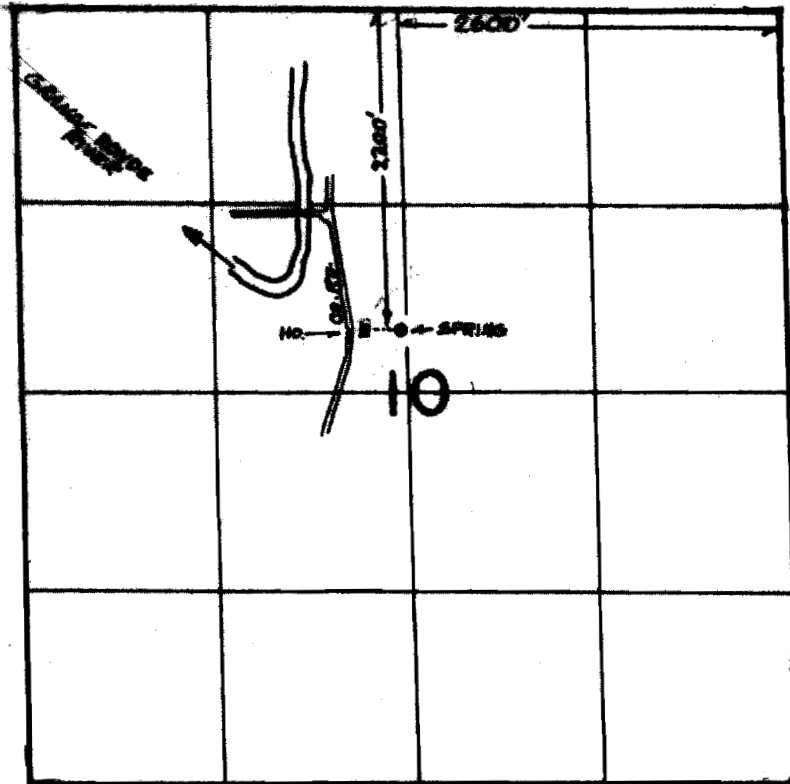

FINAL PROOF SURVEY
UNDER

Application No. 42081 Permit No. 31961
IN NAME OF

DICK HIBBERD

Surveyed 7-12 1972, by B. MUCKEN