


T. 5 S. R. 7 W. W.M.

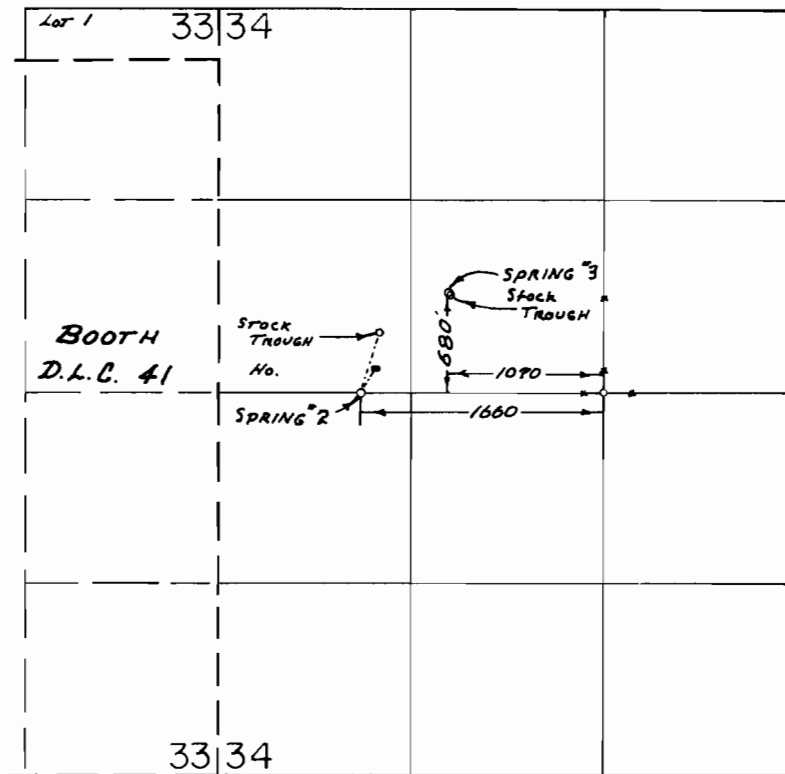

**FINAL PROOF SURVEY**  
UNDER

Application No. 42875 Permit No. 32043  
IN NAME OF

RAYMOND ALBERT CHERNOSKY

Surveyed JULY 6 1972, by DAVID NORBY