


T.3S., R.5W., W.M.

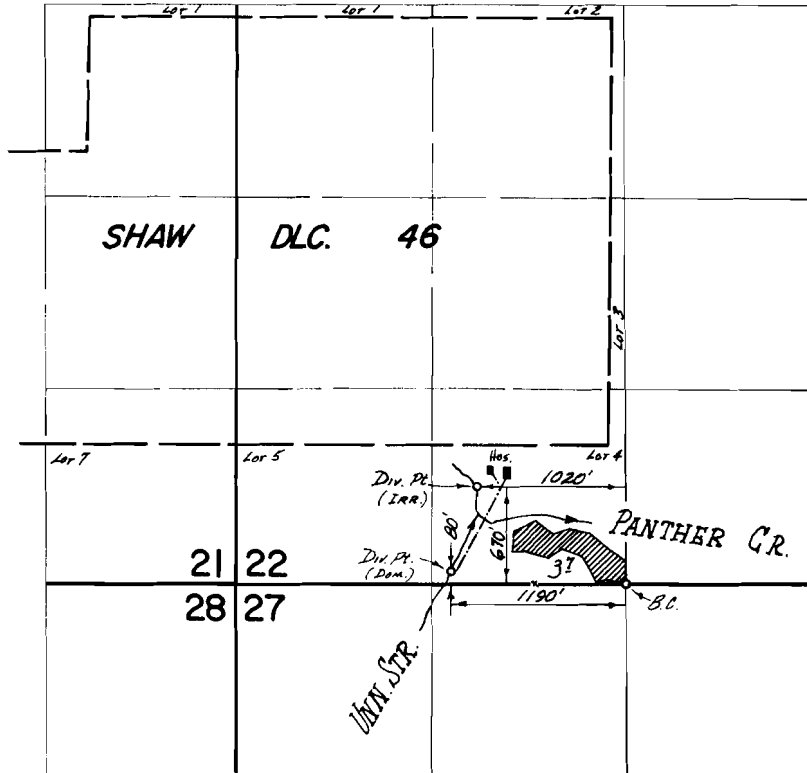

FINAL PROOF SURVEY
UNDER

Application No. 45965 Permit No. 34333
IN NAME OF

HELEN HORLYK

Surveyed SEPT. 20 1973, by L. E. GOULD