
T.4S.,R.5W.,W.M.

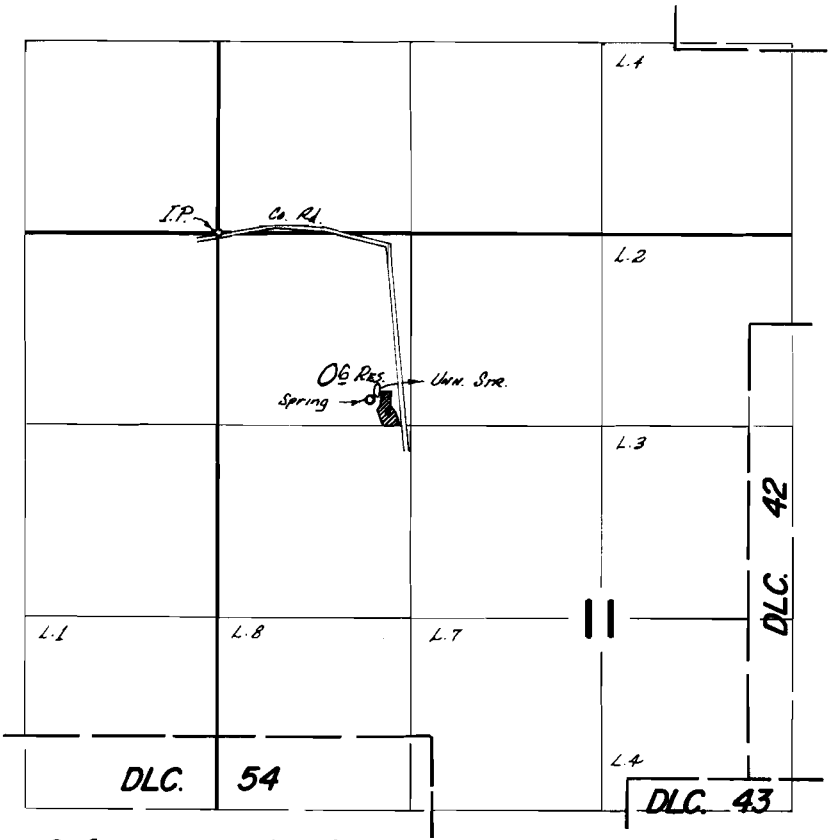

Dia. Pts. loc.: Spring - 1160' S. & 1050' E.; Unn. Str. & Res. - 1080' S. & 1120' E.; both from NW cor. Sec. 11.

FINAL PROOF SURVEY

UNDER

R-41189 R-4625

Application No. 41126 Permit No. 30660

IN NAME OF

ELVIN L. ANDERSON

Surveyed MAY 14 19 73, by D. NORBY

1973-K