


T.2N., R.3W., W.M.

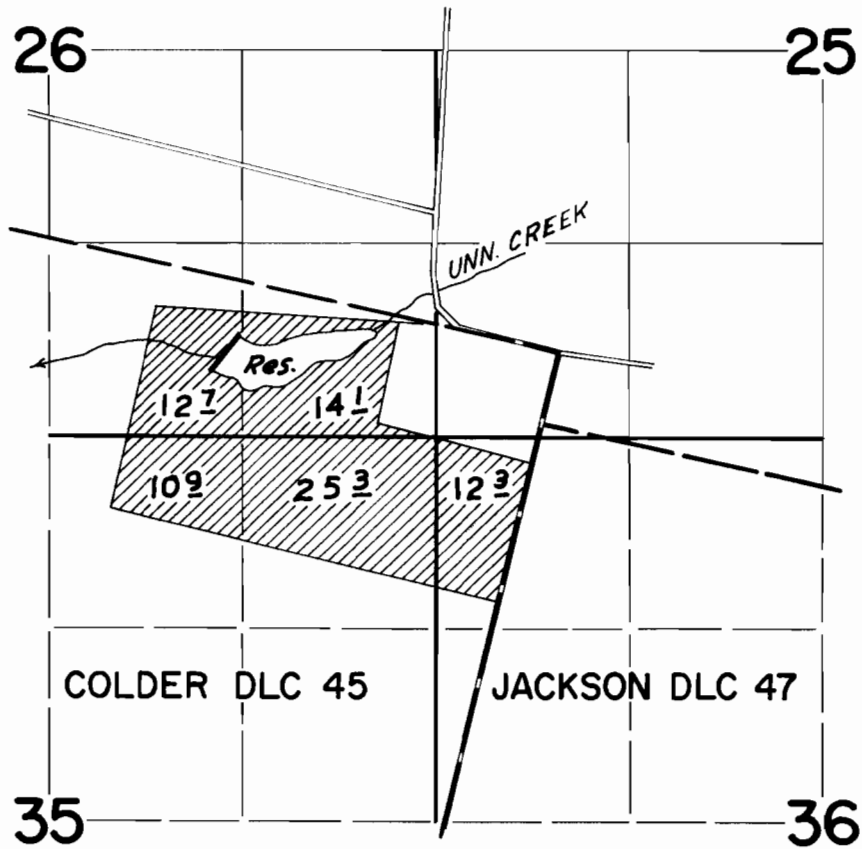

FINAL PROOF SURVEY
UNDER

R-26590 R-1314
Application No. 27027 Permit No. 21023
IN NAME OF

WILFRED P. GROSSEN

Surveyed April 23 1956, by R.H. Whitby