


T.1N. R.3W. W.M.

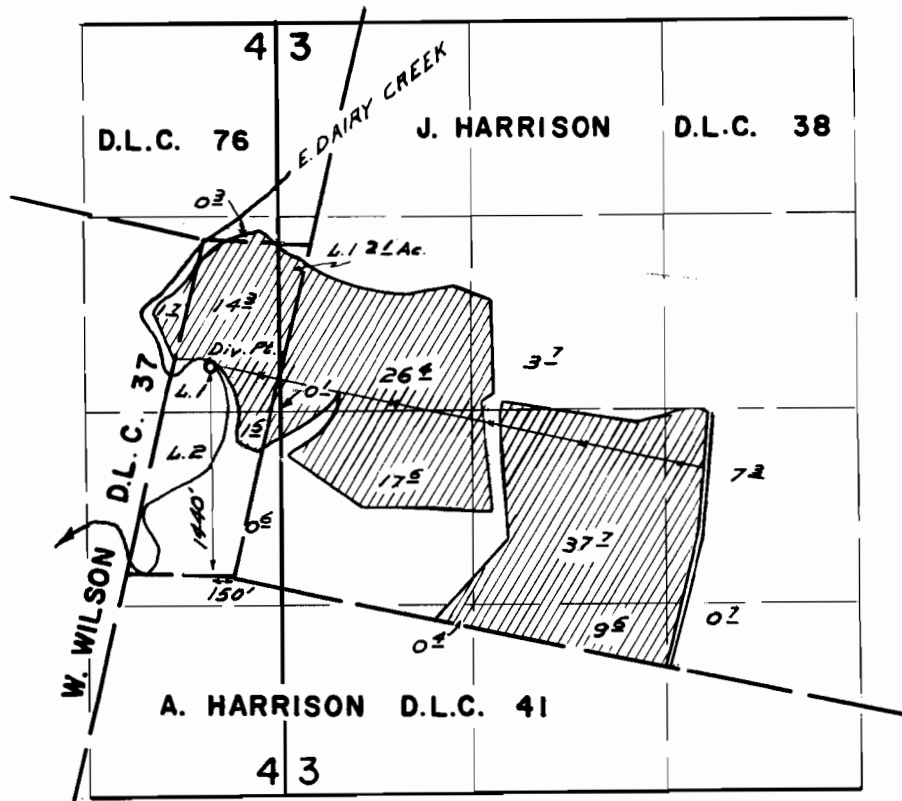

FINAL PROOF SURVEY
UNDER

Application No. 30584 Permit No. 24088
IN NAME OF

HOMER SIMANTEL

Surveyed AUG. 3 1960, by R. JACKSON