


T.39S. R.1E. W.M.

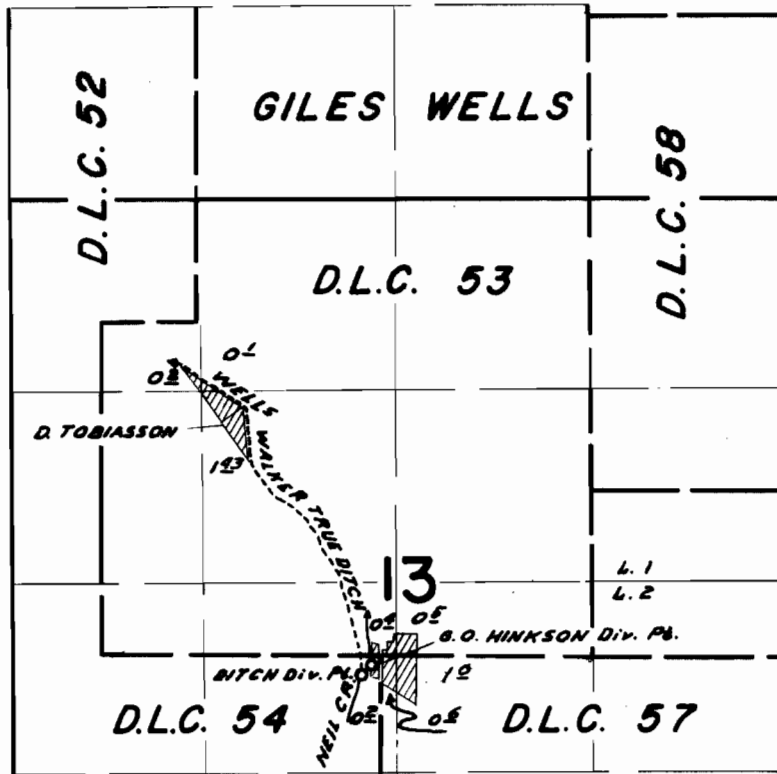

HINKSON Div. P. 60 Ft. S. & 60 Ft. W. N.E. Cor. D.L.C. 54
 DITCH Div. P. 120 Ft. S. & 120 Ft. W.

FINAL PROOF SURVEY UNDER

TRANSFER H-135

Application No. Permit No.
 IN NAME OF

D. TOBIASSON & G. O. HINKSON

Surveyed JUNE 22 1965, by L. COLEBANK