


T. 35 S. R. 7 W. W. M.

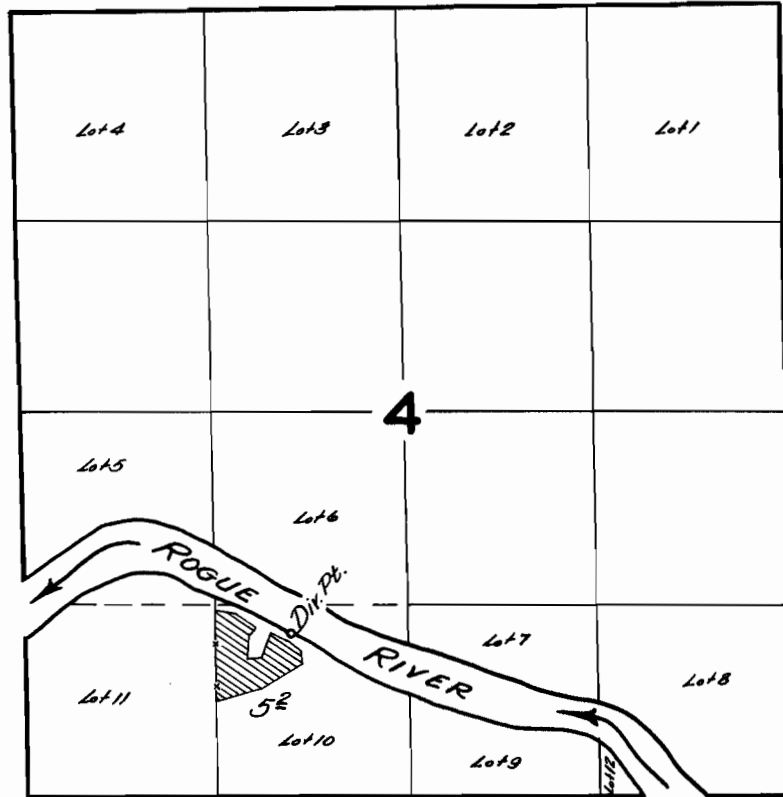

FINAL PROOF SURVEY
UNDER

Application No. 33069 Permit No. 26326
IN NAME OF

.....HARRY A. WILSON.....

Surveyed April 20 1961, by COBARTER