


F. 22482
sup 30233
41793
41794

T.8S. R.24E.W.M.

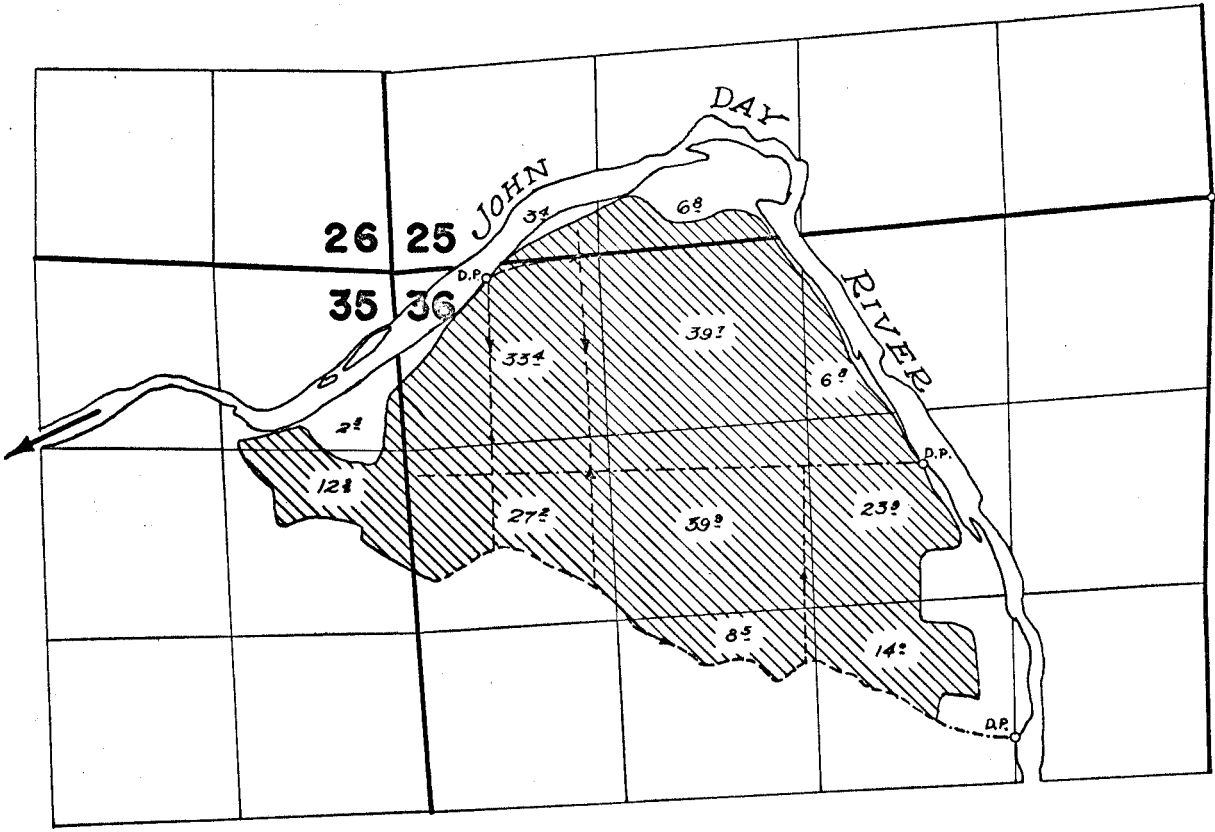

FINAL PROOF SURVEY UNDER

Application No. 29550... Permit No. 23283...
IN NAME OF

WALTER M. BRITT

Surveyed *June 23 1959*
Oct. 12 1961, by *C.O. Bartels*