


P. 23283
T - 2702

T.8S.,R.24E.,W.M.

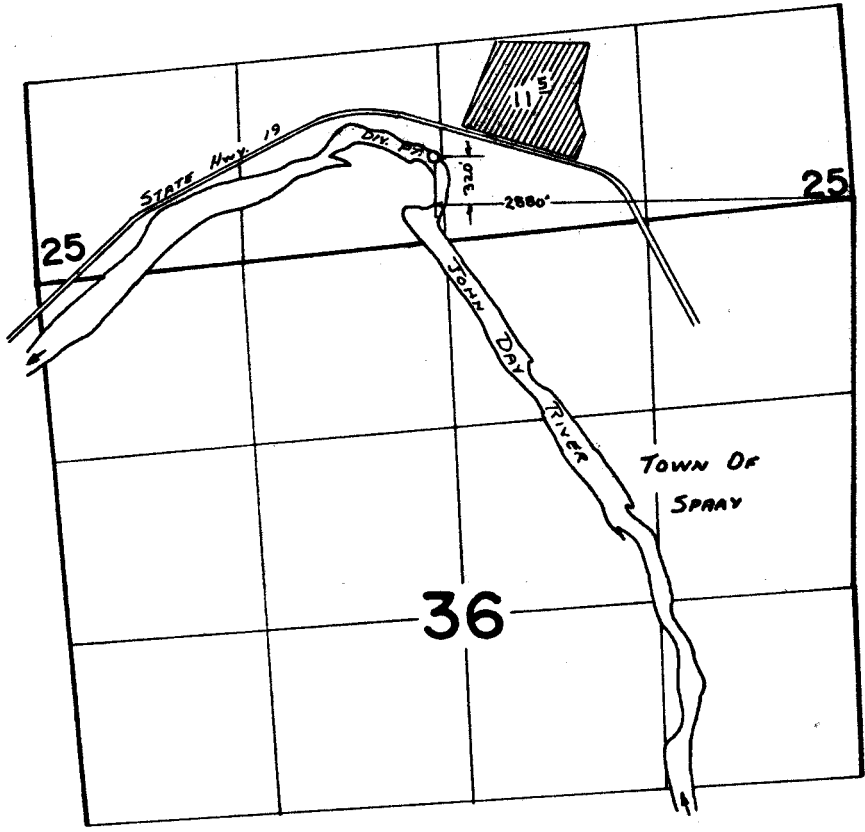

FINAL PROOF SURVEY UNDER

Transfer No. 2702 Permit No. 23283
Application No. _____ IN NAME OF C-41794
HUBERT ASHER

Surveyed Aug. 8 1974, by L. H. NUNN

DDV-12H-145
PTS 1974-5 JMT