


T. 8 S. R. 40 E. W.M.

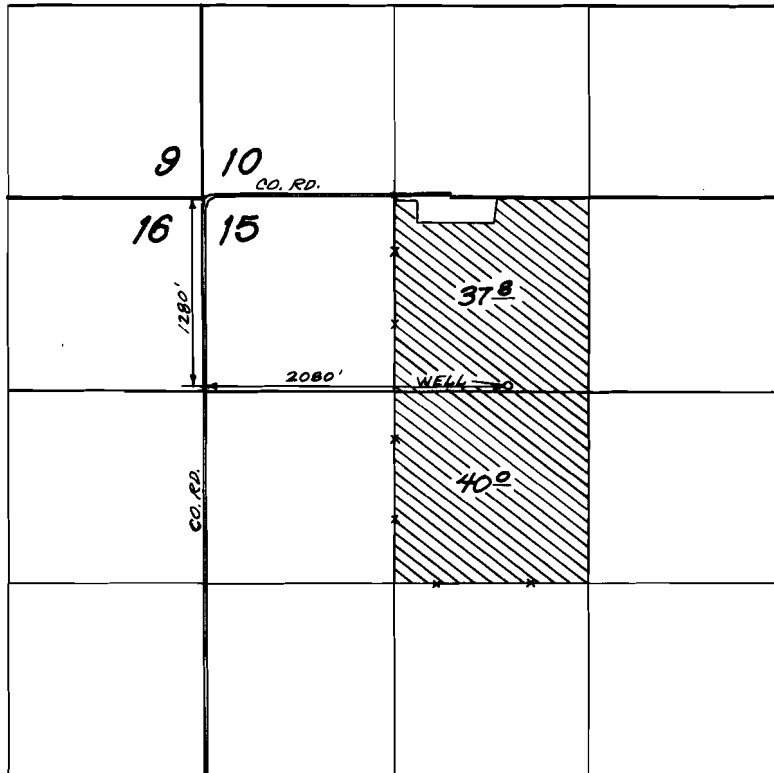

FINAL PROOF SURVEY UNDER

Application No. G 4274 Permit No. G 4025
IN NAME OF

Garn A. Brody

Surveyed OCT. 31 1974 by LM. TOLL