


T. 11 S., R. 4 W., W.M.

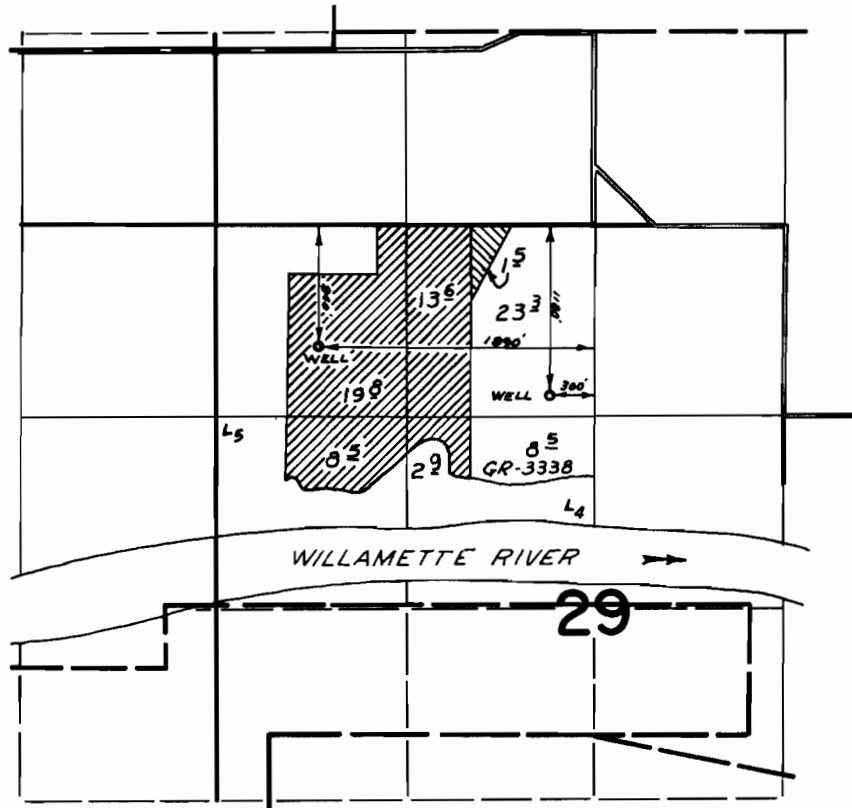

FINAL PROOF SURVEY
UNDER

 W. WELL
 E. WELL

Application No. G-3825 Permit No. G-3606
IN NAME OF

LEE GILMOUR

Surveyed MARCH 26 1973, by D. NORBY