
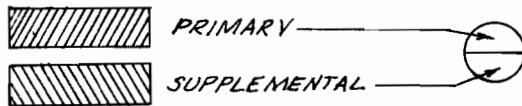


T. 10 S., R. 4 W., W. M.

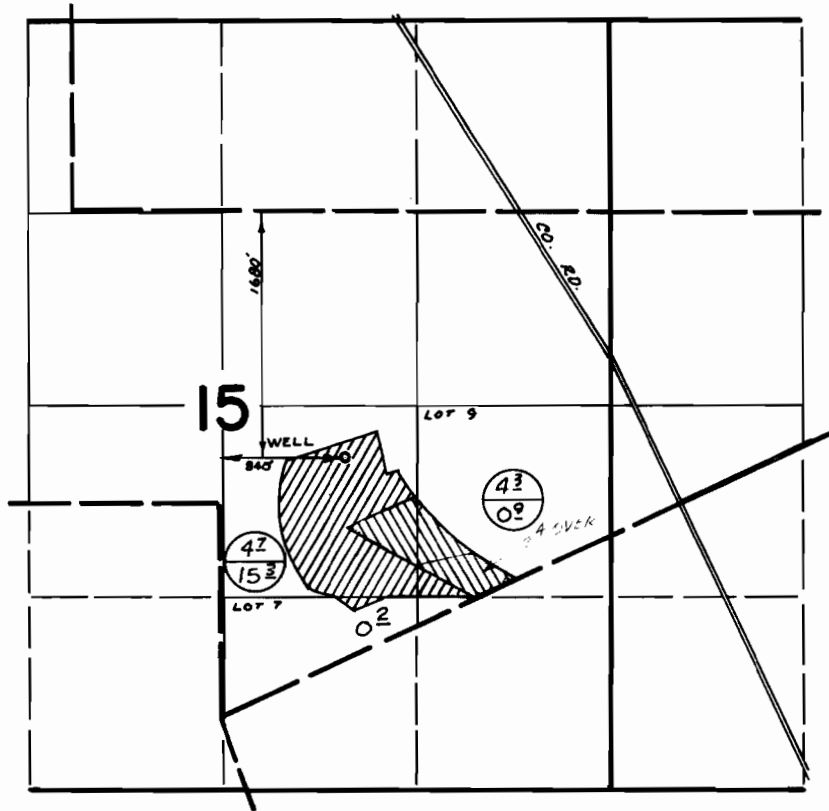

FINAL PROOF SURVEY
UNDER

Application No. G-3830 Permit No. G-3610
IN NAME OF

Ival T. Hill

Surveyed Mar. 23 1973, by D. Norby