


T.14S., R.5W., W.M.

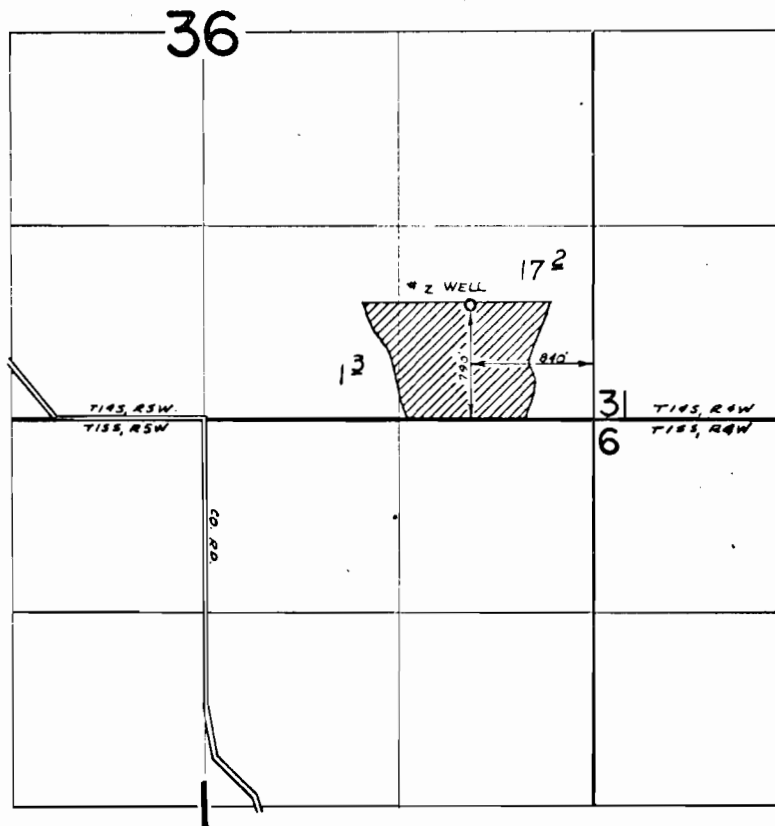

FINAL PROOF SURVEY
UNDER

Application No. G-3953 Permit No. G-3709
IN NAME OF _____

.....GLEN & NELLIE RICHARD.....

Surveyed Sept 17, 1973, by D. NORBY