


T.11S., R.4W., W.M.

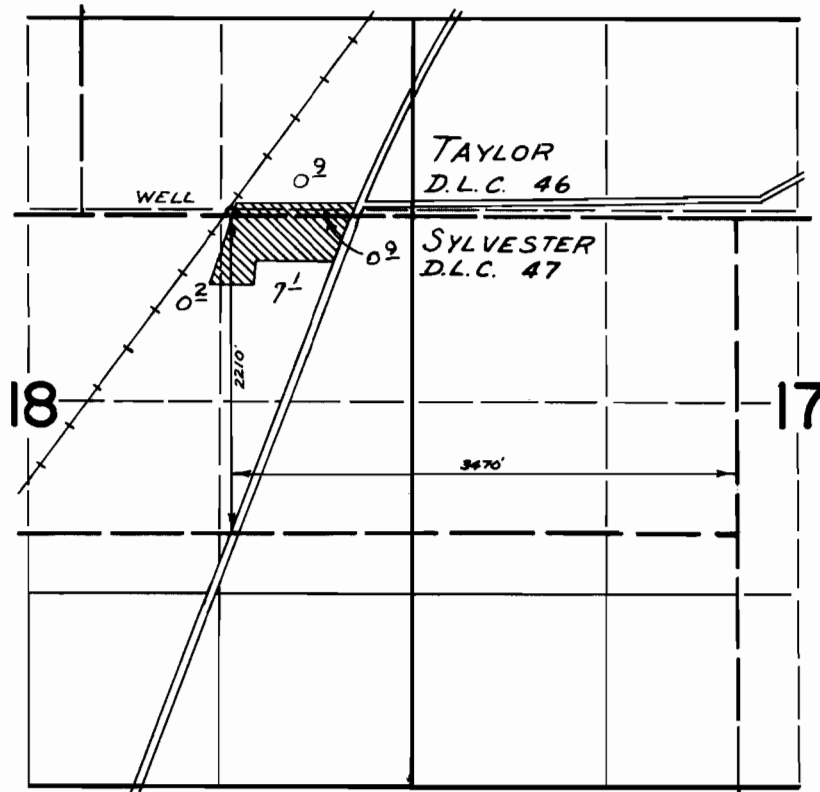

**FINAL PROOF SURVEY**  
UNDER

Application No. G-4008 Permit No. G-3760  
IN NAME OF

RAYMOND HOLMES

Surveyed MARCH 29 1973, by D. NORBY