


T.12&13S., R.5W., W.M.

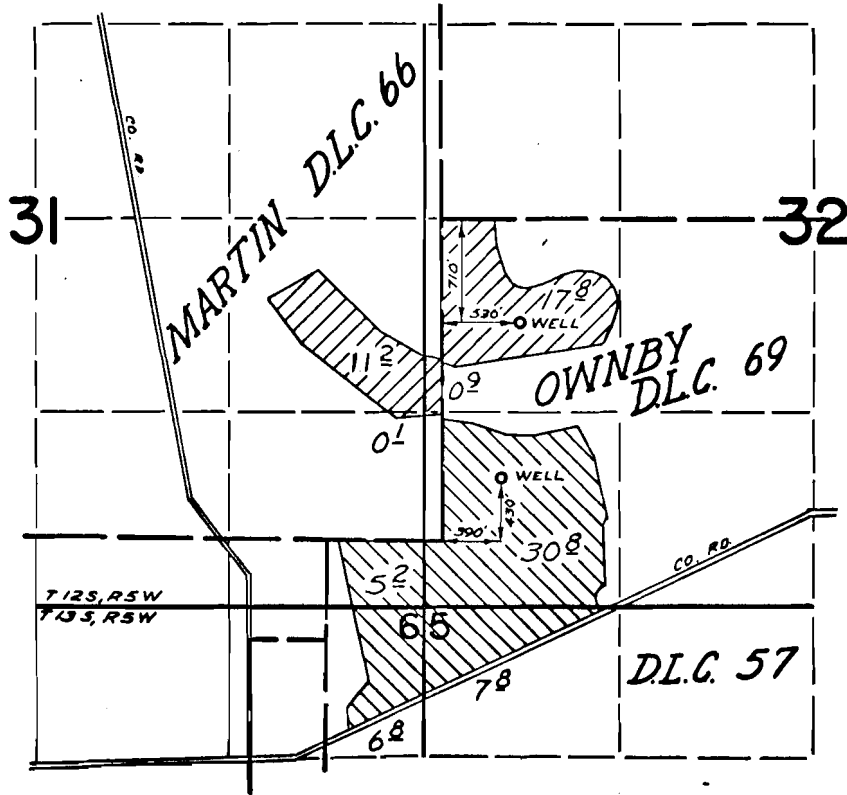

**FINAL PROOF SURVEY**  
UNDER

Application No. G-3806 Permit No. G-3591  
G-4331 G-4086  
IN NAME OF



LEIGHTON DAVIS

Surveyed MARCH 27 1973, by D. NORBY