


T.1S., R.4W., W.M.

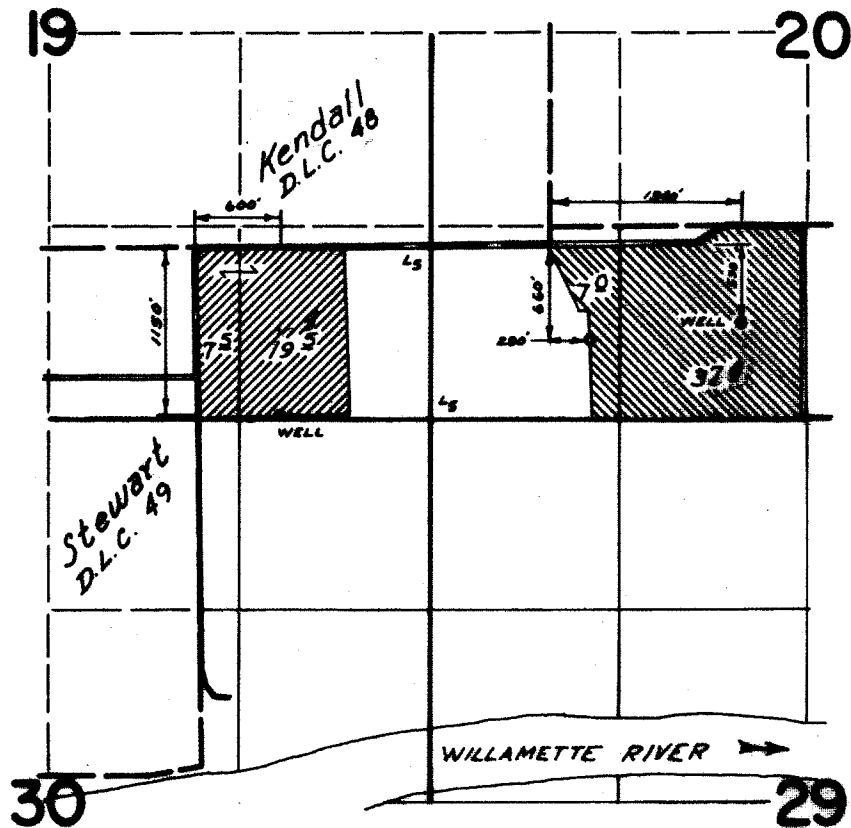

FINAL PROOF SURVEY UNDER

Application No. G-4825 Permit No. G-4544
G-4826 G-4545

IN NAME OF

A.D. AND MARIE R. BELNAP

Surveyed March 20 1973, by D. Norway

