



T.11S., R.4W., W.M.

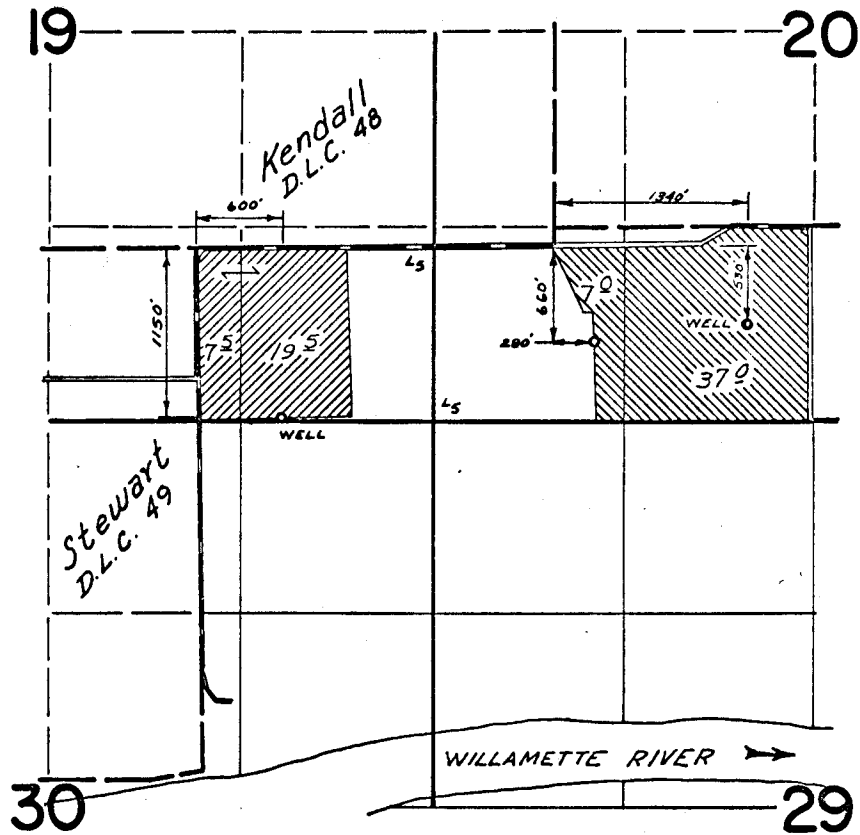

FINAL PROOF SURVEY
UNDER

Application No. G-4825 Permit No. G-4544
G-4826 IN NAME OF

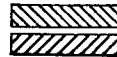

A.D. AND MARIE R. BELNAP

Surveyed MARCH 28 1973 by D. NORBY