


T.14S., R.4W., W.M.

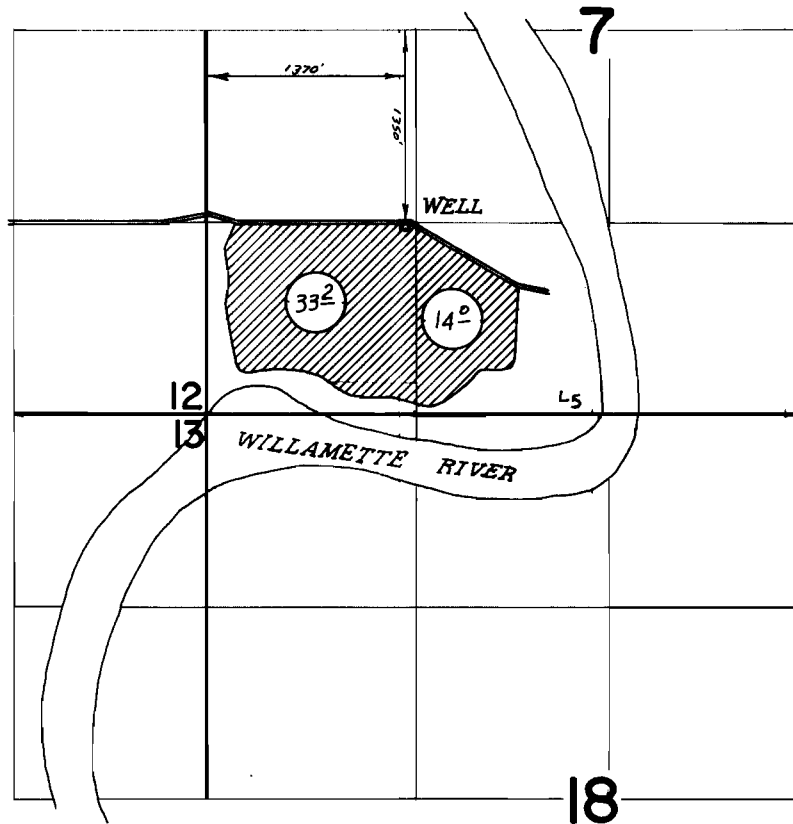

FINAL PROOF SURVEY
UNDER

Application No. G-5046 Permit No. G-4756
IN NAME OF

KEITH A. AND NANCY; SAMUEL M. AND FLORA CROCKER

Surveyed APRIL 24 1974, by D. NORBY