


T.13S.,R.48&5W.,W.M.

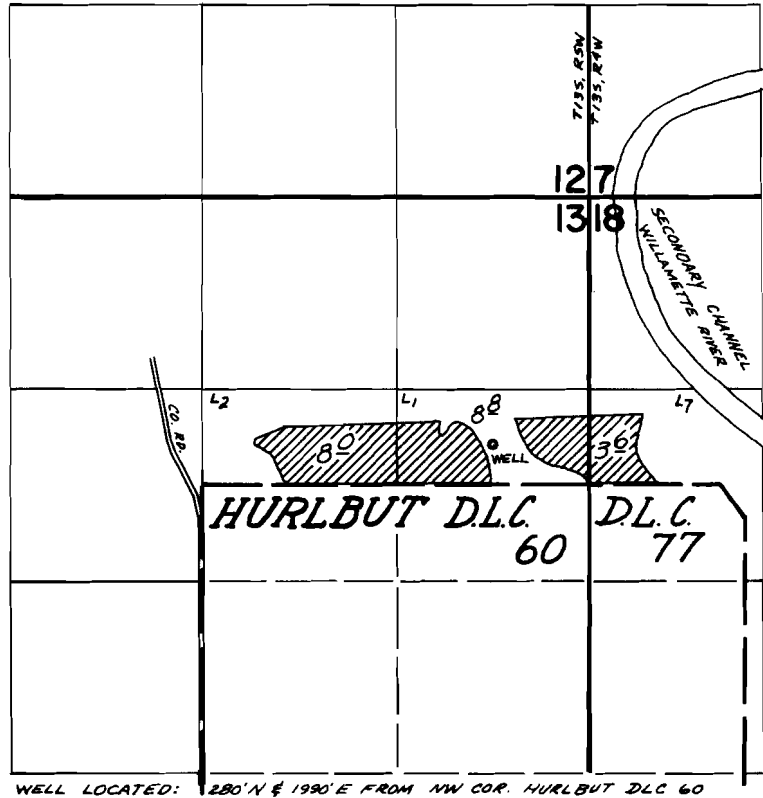

FINAL PROOF SURVEY
UNDER

Application No. G-5107 Permit No. G-1850
IN NAME OF

NEIL E. VANDERBURG

Surveyed June 8 1973, by D. Norby