


T.15S., R.5W., W.M.

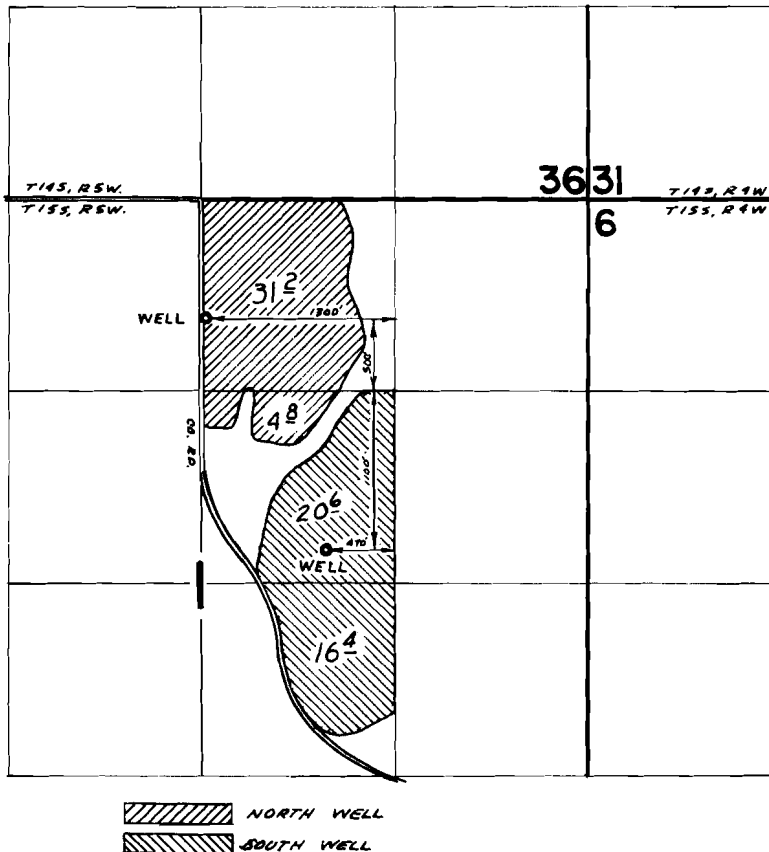

FINAL PROOF SURVEY
UNDER

Application No. G-5640 Permit No. G-4937
IN NAME OF

L.W. RUTHERFORD

Surveyed Sept. 17 1973, by D. NORBY