


T.12S. R.5W. W.M.

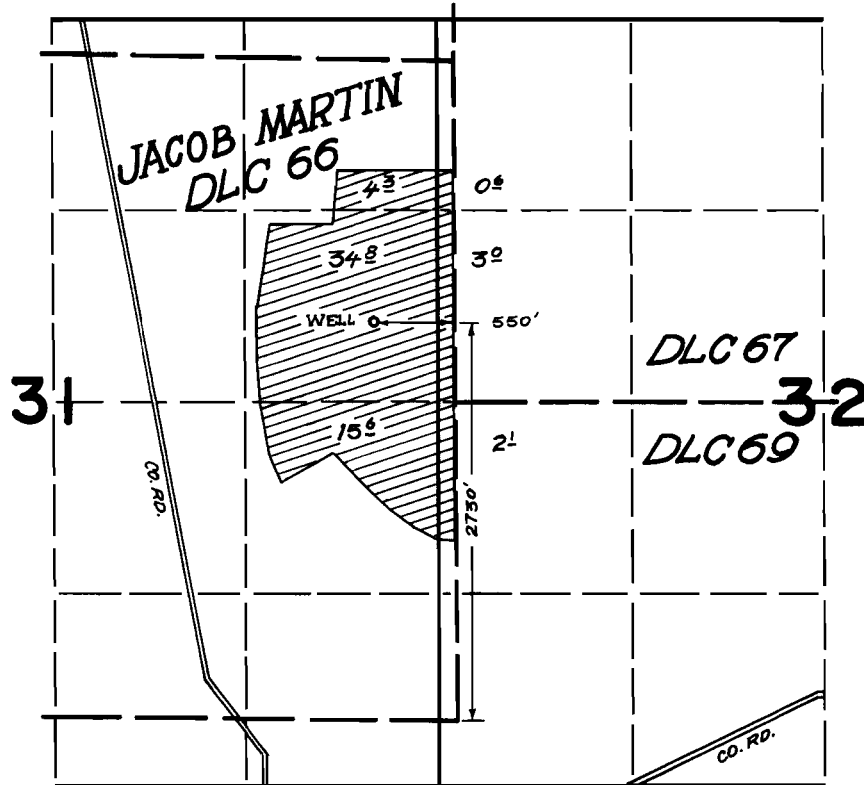

FINAL PROOF SURVEY  
UNDER

Application No. ~~65435~~ Permit No. ~~64952~~  
IN NAME OF

.....LEIGHTON DAVIS.....

Surveyed JULY 5, 1974, by L.M. TOLL.....