


T.15S., R.5&6W., W.M.

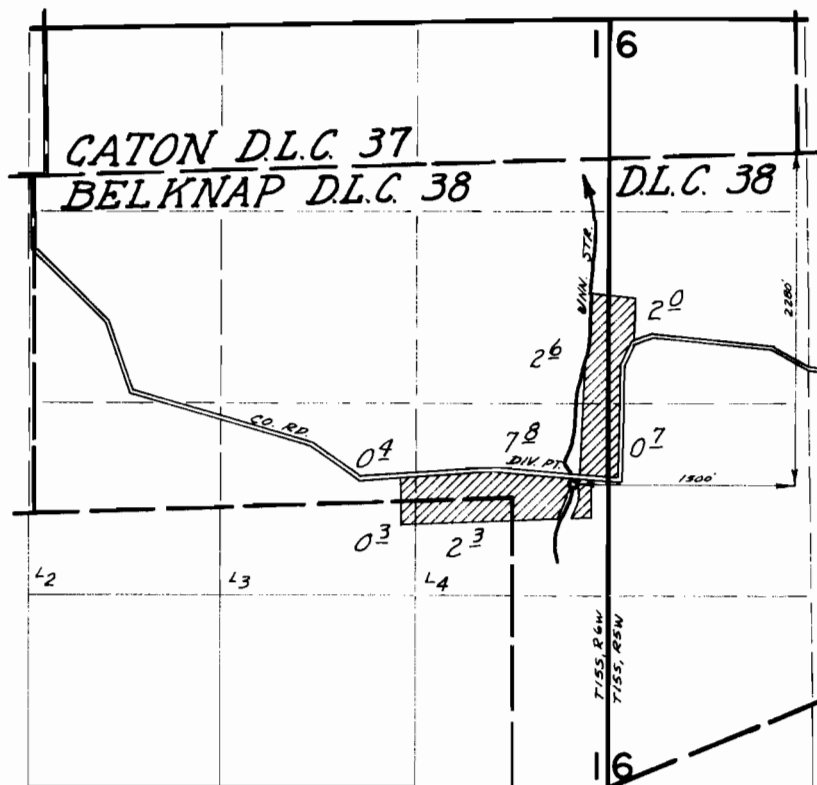

FINAL PROOF SURVEY
UNDER

Application No. 39090 Permit No. 29102
IN NAME OF

JOE MAUGHAN

Surveyed Sept. 20 1973, by D. Norby