


T.12S., R.5W., W.M.

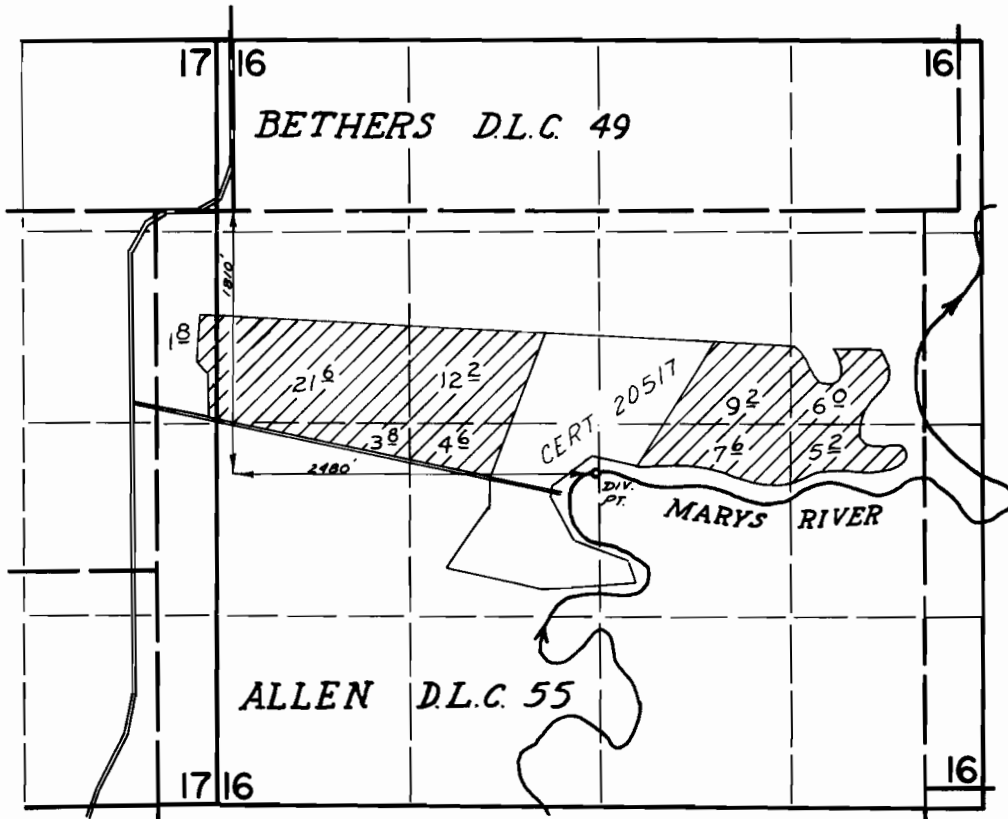

FINAL PROOF SURVEY
UNDER

Application No. 40648 Permit No. 30280
IN NAME OF

H. L. WATENPAUGH

Surveyed MARCH 27 19 73, by D. Noeby