


T.14S., R. 8W., W.M.

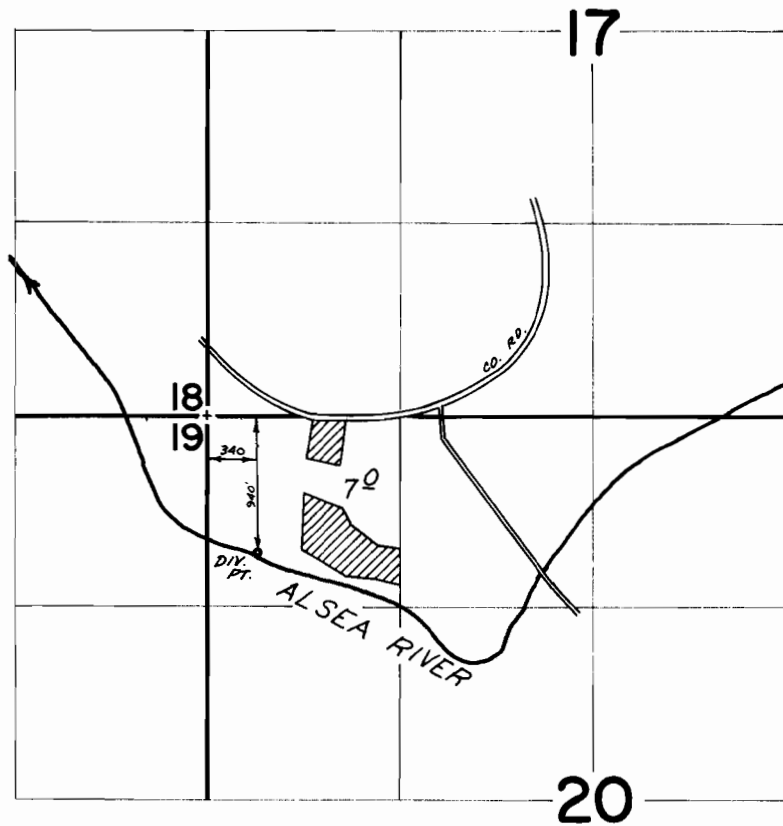

FINAL PROOF SURVEY
UNDER

Application No. 42340 Permit No. 31722
IN NAME OF

VERNON B. AND VERDA E. HALL

Surveyed APRIL 27 1973, by D. NORBY