


T.12 S., R.6 W., W.M.

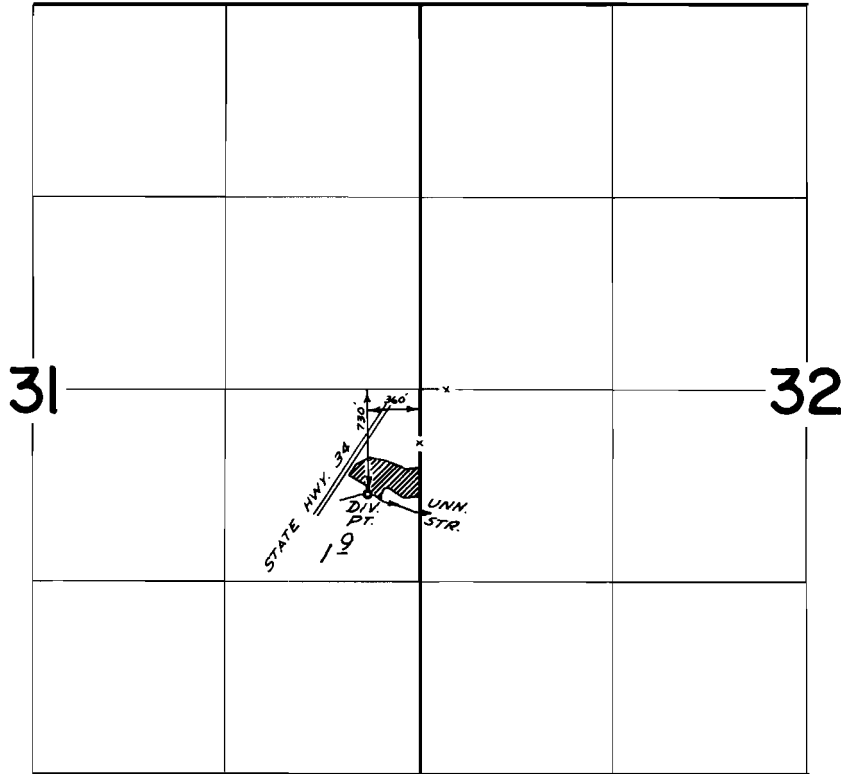

FINAL PROOF SURVEY
UNDER

Application No. 42708 Permit No. 31909
IN NAME OF

GARVIN CRABTREE

Surveyed March 29 1973 by D. Norby