


T. 10 S., R. 7 W., W.M.

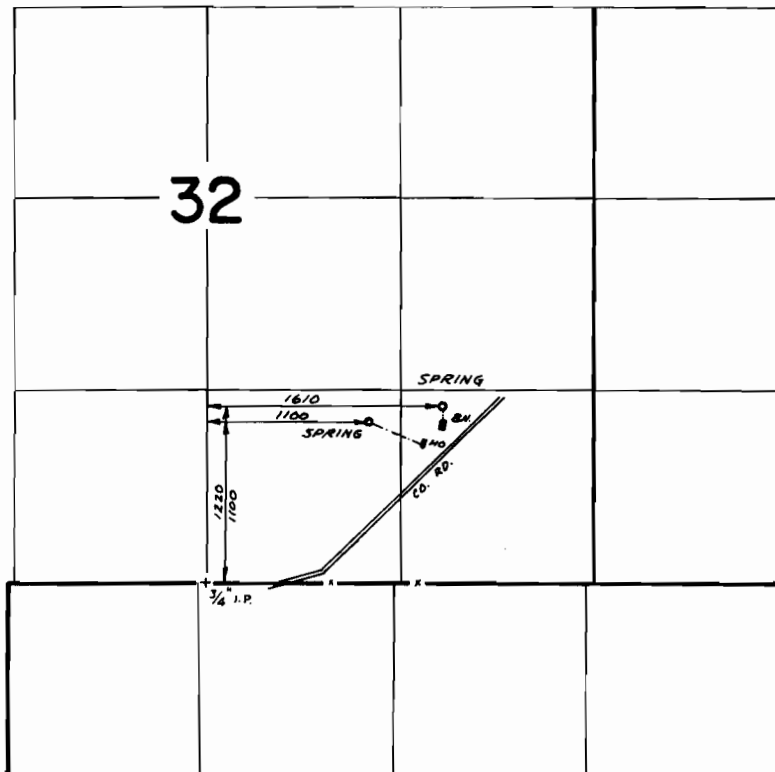

FINAL PROOF SURVEY
UNDER

Application No. 43277 Permit No. 32345
IN NAME OF

WAYNE L. HOWARD & JAMES SHROYER

Surveyed MAR 22 1973, by D. NORBY