


T.13S., R.6W., W.M.

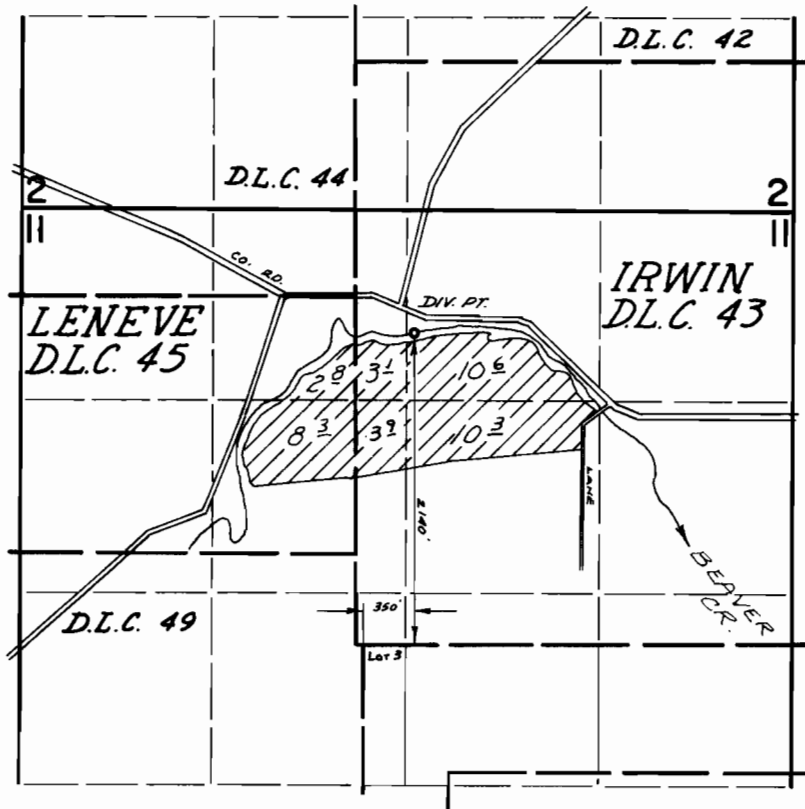

FINAL PROOF SURVEY
UNDER

Application No. 43291 Permit No. 32356
IN NAME OF

HENRY L. DUNN

Surveyed MARCH 28 1973, by D. NORBY