


T. 12 S., R. 6 W., W.M.

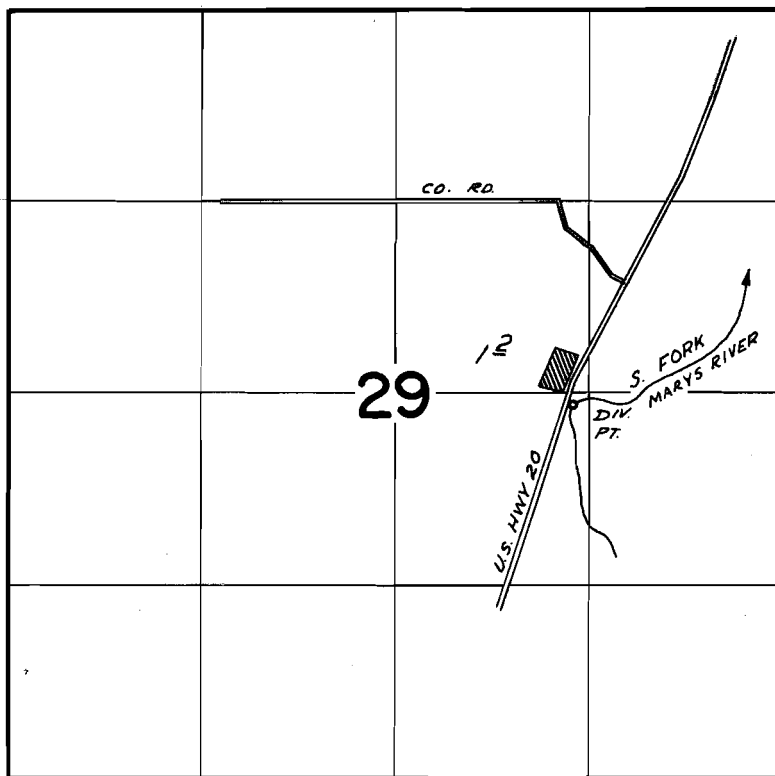

DIV. PT. LOCATED: 2740' S & 1440' W FROM NE COR. SECTION 29

FINAL PROOF SURVEY
UNDER

Application No. 43892 Permit No. 32808
IN NAME OF

BEN AND MARY GOOCH

Surveyed March 29 1973 by D. Norby