


T. 12 S., R. 5 W., W. M.

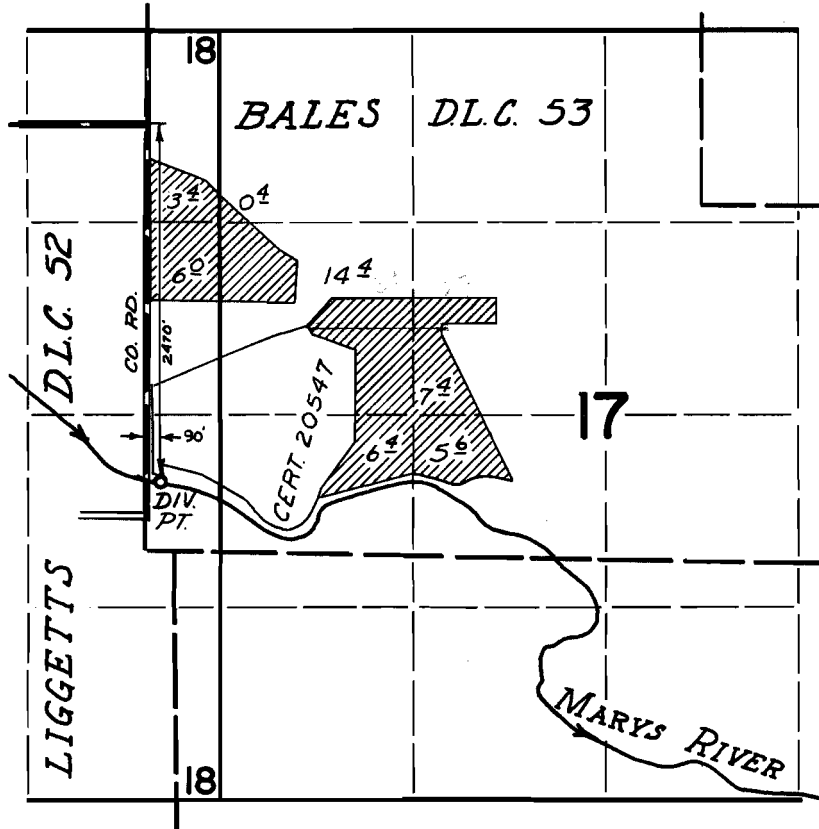

FINAL PROOF SURVEY
UNDER

Application No. 44482 Permit No. 33269
IN NAME OF

C. W. MANN

Surveyed March 27 1973, by D. Noesby