


T.15S., R.5W., W.M.

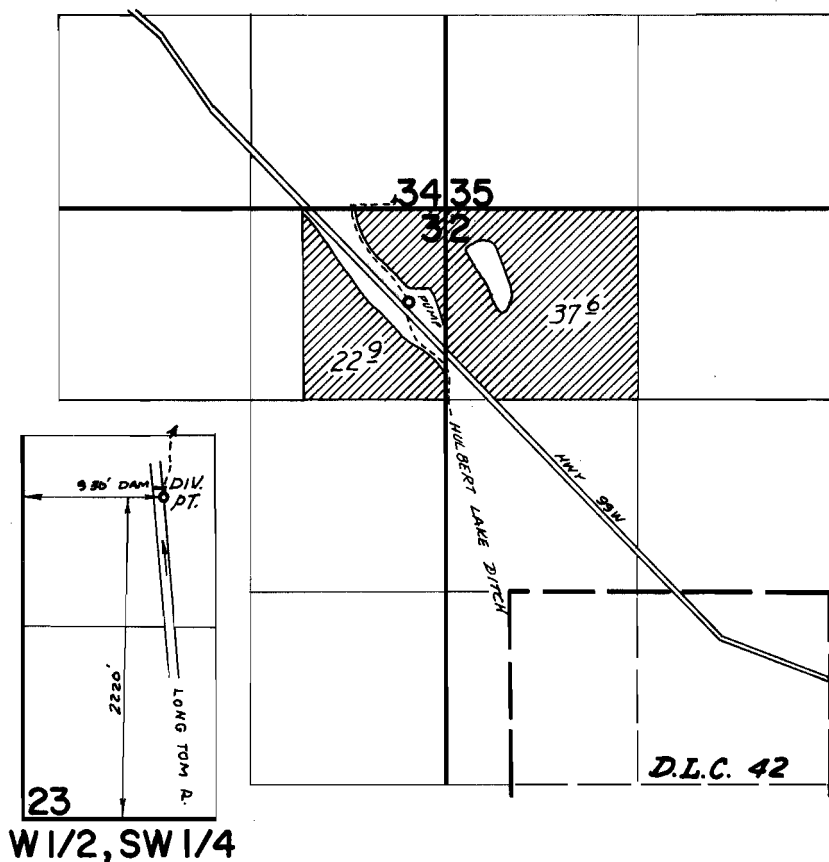

FINAL PROOF SURVEY
UNDER

Application No. 44576 Permit No. 33416
IN NAME OF

JAMES H. AND JULIA MAE MILLER

Surveyed Sept 19 1973, by D. Norby