


T.14 S., R. 8 W., W.M.

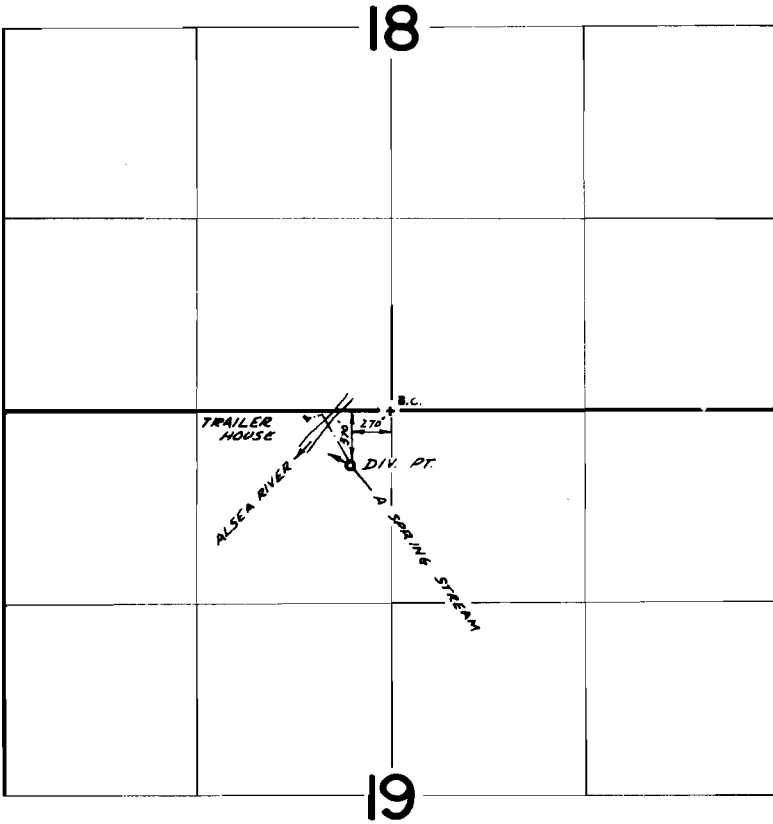

FINAL PROOF SURVEY
UNDER

Application No. 46090 Permit No. 34438
IN NAME OF

THOMAS J. & GERALDINE McCLELLAN

Surveyed APRIL 26 1973, by D. NORBY