


T.14S., R.8W., W.M.

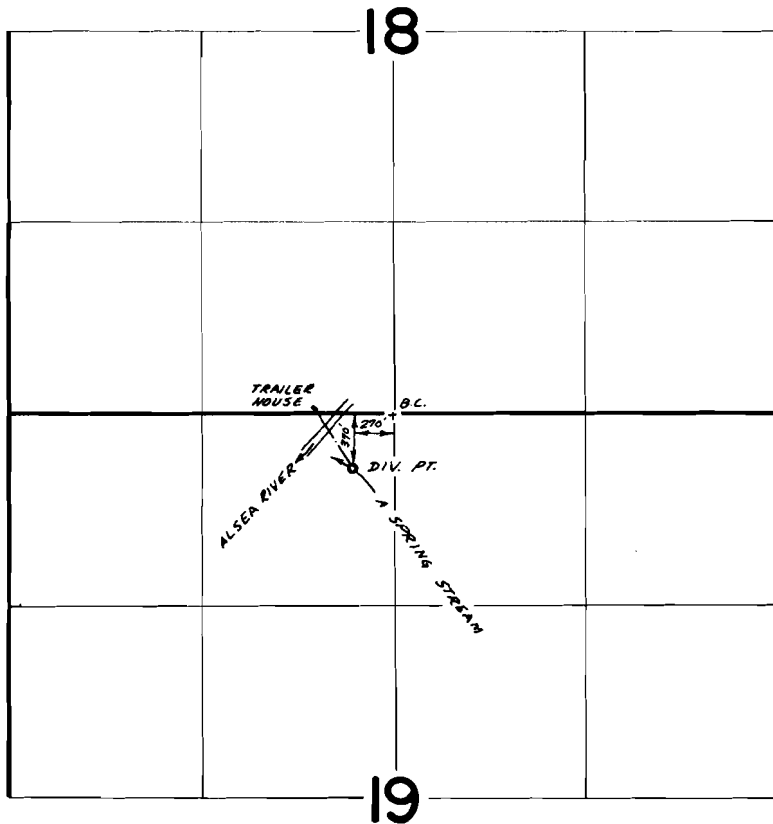

FINAL PROOF SURVEY
UNDER

Application No. 46261 Permit No. 34561
IN NAME OF

HOMER E. AND RUTH M. YOUNG

Surveyed APRIL 26 1973, by D. M. NORBY