


T.13&14S., R.7W., W.M.

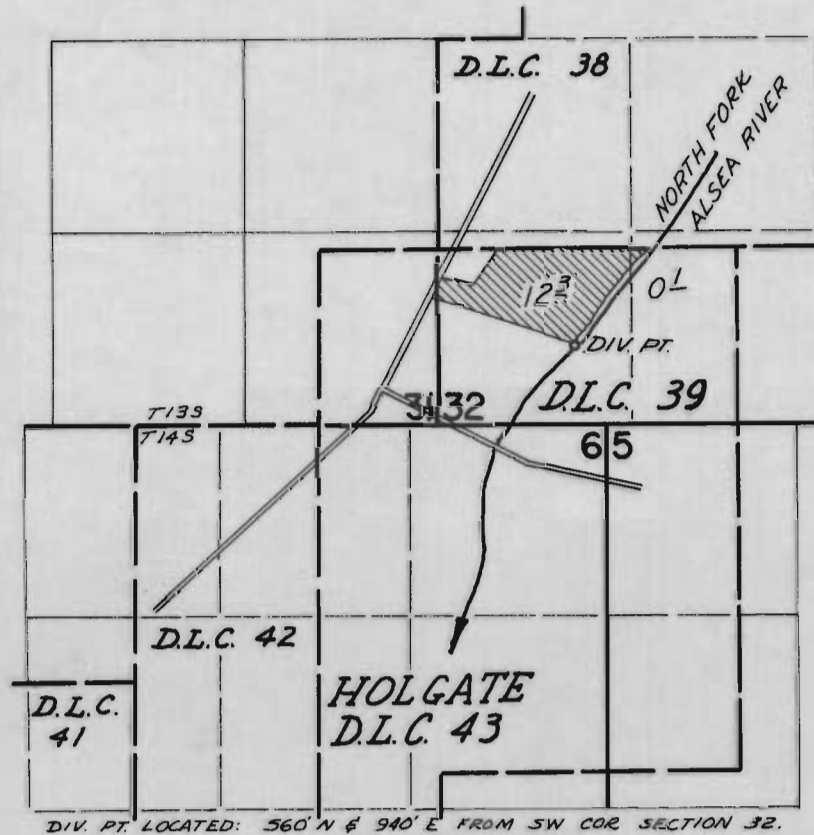

DIV. PT. LOCATED: 560' N & 940' E FROM SW COR. SECTION 32.

**FINAL PROOF SURVEY**  
UNDER

Application No. 48134 Permit No. 35246  
IN NAME OF

F.M. BEARD

Surveyed August 23 19 73, by D. Norby