


T. 10 S., R. 7 W., W.M.

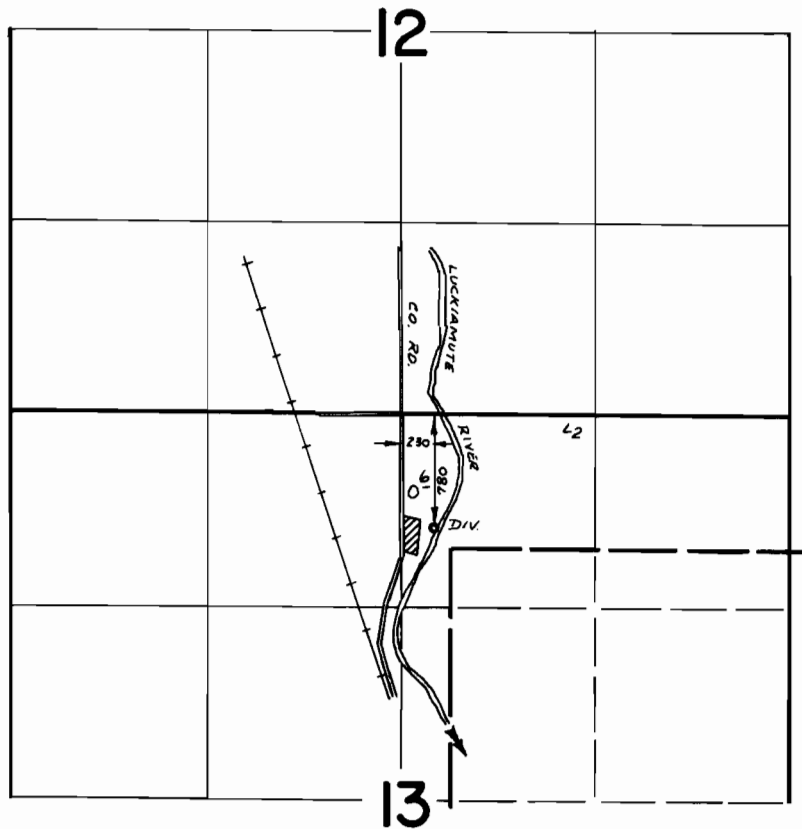

FINAL PROOF SURVEY
UNDER

Application No. 47173 Permit No. 35315
IN NAME OF

GEORGE W. AND EDNA L. DICKASON

Surveyed MAR 22 1973, by D. NORBY