


T.13S., R.5W., W.M.

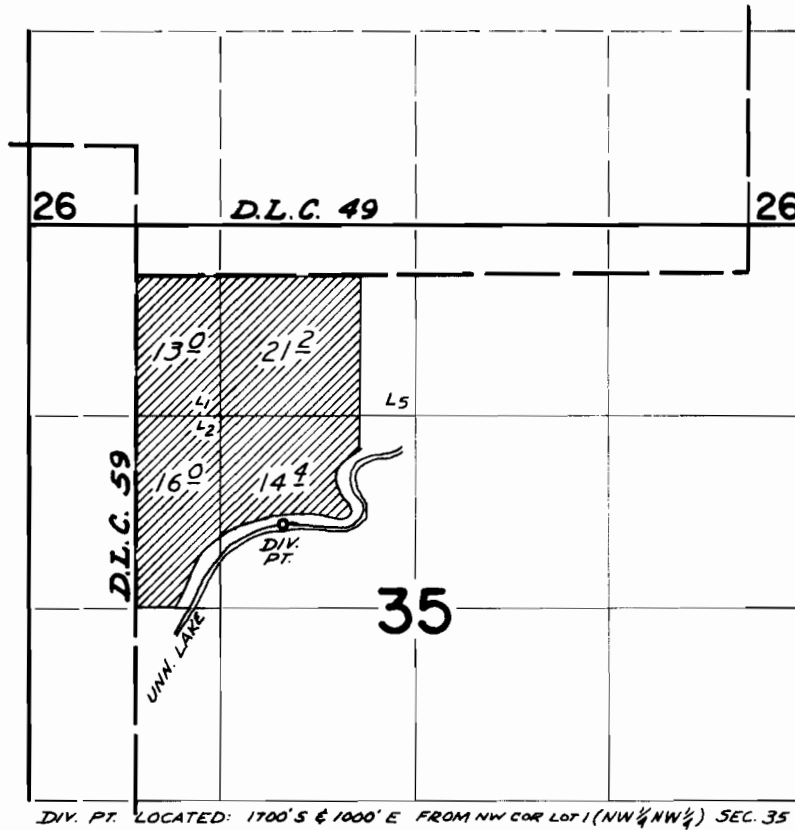

**FINAL PROOF SURVEY**  
UNDER

Application No. 47210 Permit No. 35363  
IN NAME OF  
DAN TRACER

Surveyed MARCH 30 1973, by D. NORBY