


# T.12 & 13S., R.5W., W.M.

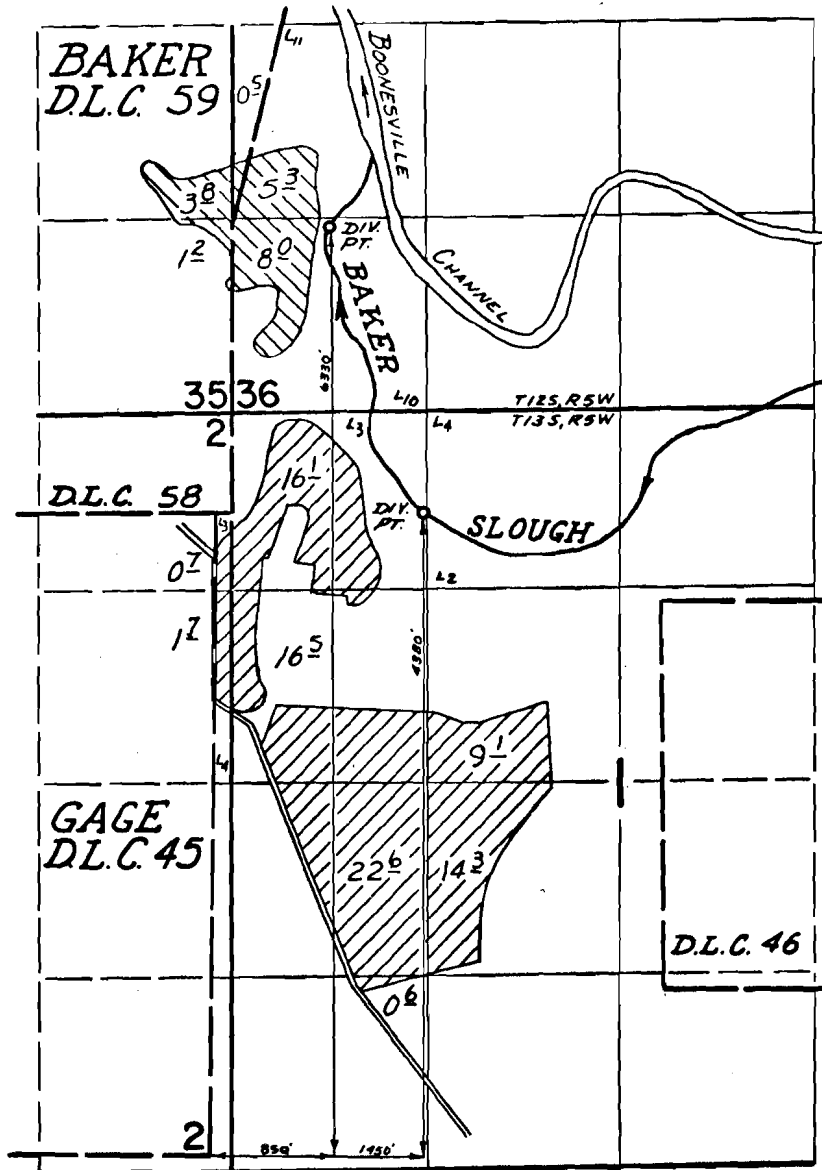

## FINAL PROOF SURVEY UNDER

Application No. 47441 / 48237 Permit No. 35545 / 35418  
IN NAME OF

CARL LOVELADY

Surveyed June 6, 1973, by D. NORBY

