


T.12S., R.6W., W.M.

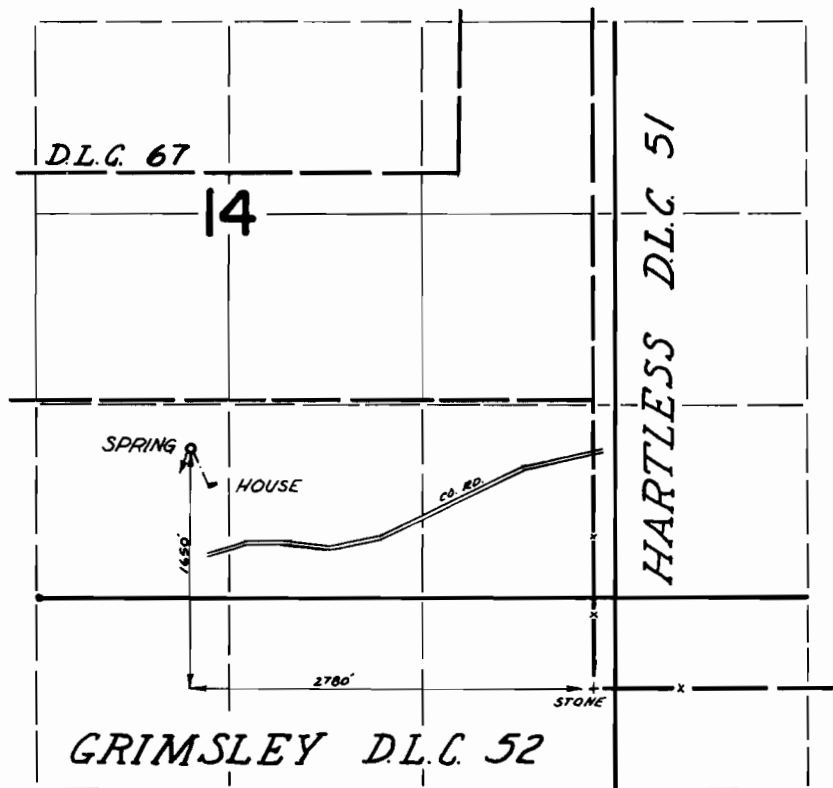

FINAL PROOF SURVEY
UNDER

Application No. 47519 Permit No. 35587
IN NAME OF

ROBERT E. VINCENT

Surveyed March 28 1973, by D. Noeby